

Section 30 Township 19 Range 12W

Well No. #6 Harris (A)

Company W. L. Hartman

NORTH

		0					

WEST

EAST

SOUTH

3

Sec. 30 Twp. 19 R. 12W

Well No. #6 Harris (A) Farm

W. L. Hartman Company

Contractor

Ft. Zarah


330 Ft. from N. Line

Ft. from S. Line

990 Ft. from E. Line

Ft. from W. Line

NW NE NW

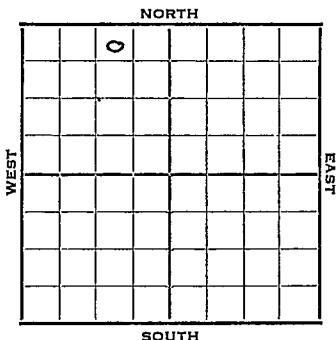

1952

Elev. 1830'

REPORT

1/16

Spud 1-12-52

8" @ 160

Drig. 969'

2/6

TD 3418' 5" @ 3416

2/13

CO to 3418' Fill up 2200' oil 12 hrs
POP

2/20

POP

3/5

NR

3/11

"

3/19

"

3/26

Spud 1-12-52

Oil Well TD 3418 8" @ 160

Top 2392 Heeb. 3029

Br Li 3144 Lans. 3158

Cong. 3403 Arb. 3415

TD 3418 5" @ 3416 CO to 3418

FU 2200' oil 12 hr.

Comp. 204 bopd 2% wtr.

COMPLETED

County Barton State Kansas

Sec. 30 (Blk. 19) (Sur. 12W) (Twp.) (Rge.) Map No.

Operator W. L. Hartman

Well No. 6 Farm Harris (A)

Elev. _____ Location NW NE NW

FIRST REPORT

330 Ft. From N Line NW

990 Ft. From E Line Quarter

Ist. Report JAN 16 1952

Completion _____

Remarks _____

Spudding Date 1-12-52

Drlg. Data Ft. Zarah

8" @ 160 Drlg. 969

J. E. TYRA

