


Section 30 Township 19 Range 12 W

Well No. # 6 Harris "C"

Company National Assoc. Pet.

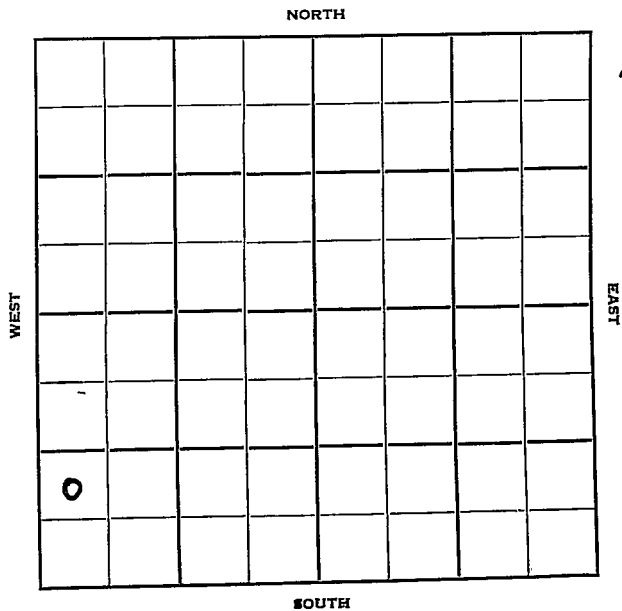

Sec. 30 Twp. 19 R. 1/12W

Well No. #6 Harris "C" Farm

National Assoc. Pet. Company

Hartman - Contr. Contractor


\_\_\_\_\_ Ft. from N. Line

990' Ft. from S. Line

\_\_\_\_\_ Ft. from E. Line

330' Ft. from W. Line

NW SW SW

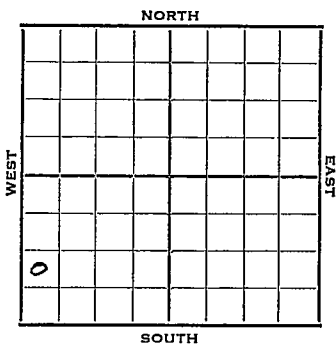

1952 Elev. 1826' REPORT

4/23 Spud 4-18-52  
8" @ 191  
Anhy 649  
Drlg. 2093

4/30 NR

5/7 Heeb 2998' Br Li 3113' Lans. 3127'  
DST 3129-57, 1 hr, 940' gas, 140' 0 & -  
GCM, 750#  
DST 3161-80 1 hr, 32' M 980#  
DST 3193-3206, 50 mins, 900' SW 150#  
DST 3256-80, 1 hr, 10' SOCM 0#  
Cong. 3367'  
DST 3333-69, 1 hr, 30' SOCM 0#  
Arb. 3402' RTD 3405' 5" @ 3402'  
DP CO 3405' 500 A  
F/90 BO 2 hrs.

5/14 NR

5/21 Spud 4-18-52  
Oil well TD 3405' 8" @ 191  
Anhy 649' Heeb 2998' Br. li 3113'  
Lans. 3127'  
DST 3129-57 open 1 hr. rec 940' gas  
140' 0 & GCM  
DST 3161-80 open 1 hr. rec 32' mud  
DST 3193-3206 open 50 min, rec 900' SW  
DST 3256-80 open 1 hr. rec 10' SOCM  
Cong. 3367'

OVER

1952

5/21

(Information continued)

DST 3333-69 open 1 hr. rec 30' SOCM.

Arb. 3402' TD 3405' 5" @ 3401

CO to 3405' 500 A F/90 BO 2 hr.

Comp. BHB 620 BOPD

**COMPLETED**



