
O.W.D.D KANSAS

FORM 51 25M 3-49 PETROL Barton

Section 30 Township 19 Range 12W

Well No. #8 Harris (A)

Company Prough Petroleum National Assoc.

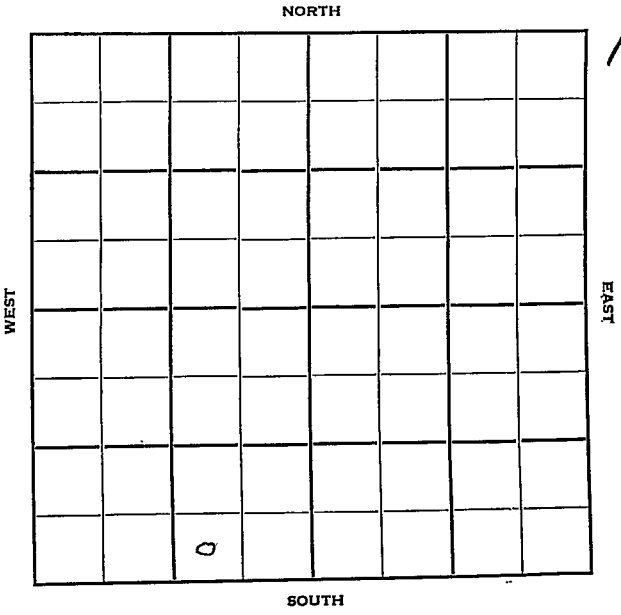

FORM 2252-A 10M-11-50 PETROL W. D. D

Barton

KANSAS

Sec. 30 Twp. 19 R. 12W

Well No. #8 Harris (A) Farm

Prugh Petro.
~~National Assoc.~~ Company

Contractor

Ft. Zarah Pool


Ft. from N. Line

330' Ft. from S. Line

990' Ft. from E. Line

Ft. from W. Line

SW SE SW

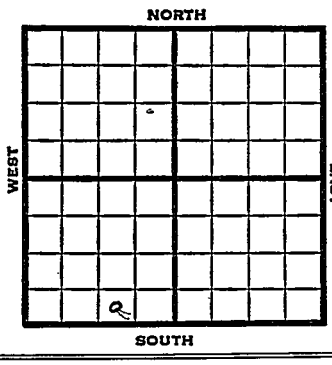

1951	Elev. 1828' REPORT
9/26	Location
12/19	Spud 10-20-51 8" @ 187' Anhy 650' Heeb. 2991 Lans. 3122 DST 3121-61 open 15 min. Rec. 300' O&GCM DST 3166-3225 open 1 hr. Rec. 195' HGCM & SSO Arb. 3384 TD 3387 5" @ 3384 DD 3392 PB 3345 13/ 3293-96 17/ 3254-58 500 A CO to 3387 500 A DD 3390 6 GW ¼ BOPH 500 A S/ 5½ BO 1 hr. S/ 4½ BO Tr. wtr. 1 hr. Comp. 40 BOPD
	COMPLETED
1953	Q. W. D. D
10/14	OTD 3345' Arb. 3384' TD 3406' 500 A S/5 BOPH 5 GW
10/21	"
11/4	P/50 bo + 48 bwpd
11/11	NR

OVER

1953
11/18 Oil Well
TD 3406'
OTD 3345'
Arb. 3384'
TD 3406', 500A
S/5 boph 5 gw
5" @ 3384'
P/59 bo 48 bwpd
P/43 bopd 40 bw
Comp. 33 bopd 50% wtr.

COMPLETED

FORM 275 FOR SALE BY KANSAS BLUE PRINT CO.


County Barton State Kansas

Sec. 30 (Blk. / Twp.) 19 (Sur. / Rge.) 12W Map No.

Operator National Assoc.

Well No. 8 Farm Harris (A)

Elev. — Location SW SE SW

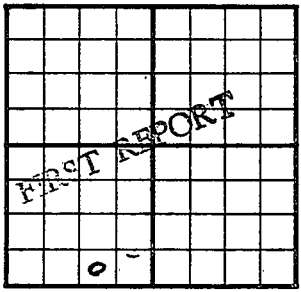

330 Ft. From S Line SW

990 Ft. From E Line Quarter

1st. Report SEP 2 6 1951

Completion

Remarks

Spudding Date

Drlg. Data Ft. Zarah — pool

Location

J. E. TYRA

FORM 275 FOR SALE BY KANSAS BLUE PRINT CO.


County Barton State Kansas

Sec. 30 (Blk. Twp.) 19 (Sur. Rge.) 12W Map No.

Operator National Assoc. Pet.

Well No. 8 Farm Harris "A"

Elev. 1828 Location SW SE SW

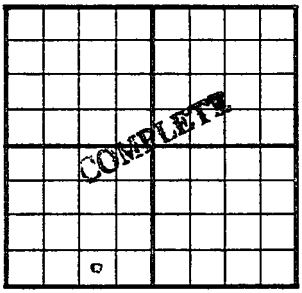

330 Ft. From S Line SW

990 Ft. From E Line Quarter

1st. Report

Completion DEC 1 9 1951

Remarks Ft. Zarah Pool

Hartman - Contr.

Spudding Date 10-20-51

Drlg. Data

8" @ 187 Anhy 650 Heeb. 2991

Lans. 3122 DST 3121-61 open 15 min.

Rec. 300' o & gcm DST 3166-3225

open 1 hr. Rec. 195' hgcm & SSO

Arb. 3384 TD 3387 5" @ 3384 DD 3392

PB 3345 13/ 3293-96 17/ 3254-58

500 A CO to 3387 500 A DD 3390

6 gw $\frac{1}{4}$ boph 500 A S/ $5\frac{1}{2}$ bo 1 hr.

S/ $4\frac{1}{2}$ bo tr. water 1 hr.

Comp. 40 bopd

J. E. TYRA

FORM 275 FOR SALE BY KANSAS BLUE PRINT CO.

O. W. D. D


County Barton State Kansas

Sec. 30 (Blk. Twp.) 19 (Sur. Rge.) 12W Map No.

Operator Prugh Petroleum

Well No. 8 Farm Harris "A"

Elev. Location SW SE SW

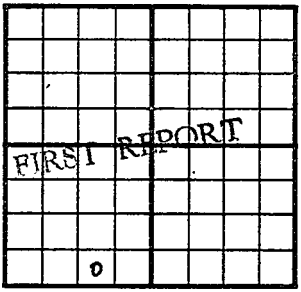

330 Ft. From S Line SW

990 Ft. From E Line Quarter

1st. Report OCT 14 1953

Completion

Remarks OWDD

O. W. D. D

Spudding Date

Drlg. Data

OTD 3345 Arb. 3384 TD 3406 500 A

S/ 5 boph 5 gw

J. G. McGEHEE

FORM 275 FOR SALE BY KANSAS BLUE PRINT CO.

O. W. D. D


County Barton State Kansas

Sec. 30 (Blk. Twp.) 19 (Sur. Rge.) 12W Map No.

Operator Prugh Petroleum

Well No. 8 Farm Harris "A"

Elev. Location SW SE SW

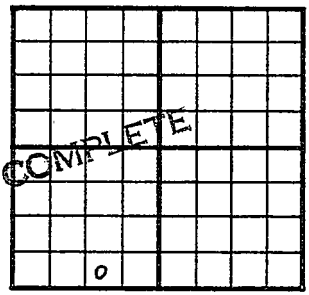

330 Ft. From S Line SW

990 Ft. From E Line Quarter

1st. Report

Completion NOV 1 8 1953

Remarks O. W. D. D.

Spudding Date

Drlg. Data Oil well TD 3406

OTD 3345 Arb. 3384 TD 3406 500 A

S/ 5 boph 5 gw 5" @ 3384 P/ 50 bo

48 bwpd P/ 43 bopd 40 bw

Comp. 33 bopd 50% wtr.

J. G. McGEHEE