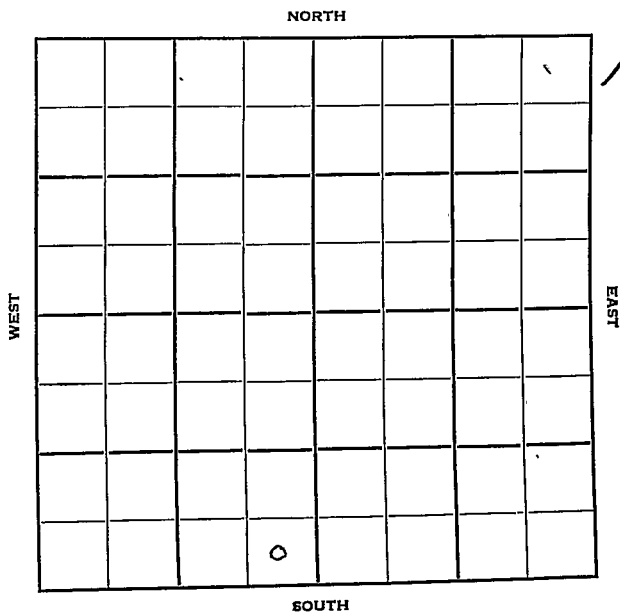


Section 30 Township 19 Range 12WWell No. #7 Harris (A)Company National Assoc.

Barton

KANSAS

Sec. 30 Twp. 19 R. 12W

Well No. #7 Harris (A) Farm

National Assoc. Company

H & H - Contr. Contractor

Ft. Zarah Pool


Ft. from N. Line

330' Ft. from S. Line

330' Ft. from E. Line

Ft. from W. Line

SE SE SW

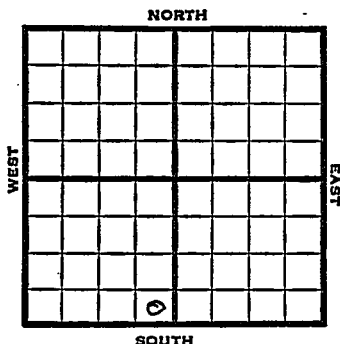

1951

Elev. 1828' REPORT

9/26

Spud 9-23-51

8" @ 190'

WOC

11/14

Spd 9-23-51

Oil Well TD 3383

8" @ 190

Heeb. 2984 Br Lime 3099

Lans. 3113 Arb. 3365-71

5" @ 3366 TD 3383

S/3 boph 1000 A S/12 boph

F/7 boph Comp. 140 bopd

COMPLETED

County	Barton		State	Kansas	
Sec.	30	(Bk. Twp.)	19	(Sur. Rge.)	12W Map No.

Operator **National Assoc.**

Well No. **7** Farm **Harris (A)**

Elev.	Location	SE	SE	SW
-------	----------	----	----	----

LAST REPORT

330 Ft. From S Line SW

330 Ft. From E Line Quarter

1st. Report **SEP 26 1951**

Completion

Remarks

H & H - Contr.


Spudding Date **9-23-51**

Drlg. Data Ft. Zarah - pool

8th @ 190° W.O.C.

J. E. TYRA

County Barton State Kansas
 Sec. 30 (Blk. 19) (Sur. 12W) Map No.
 Operator National Assoc. Pet.
 Well No. 7 Farm Harris "A"
 Elev. 1828 Location SE SE SW

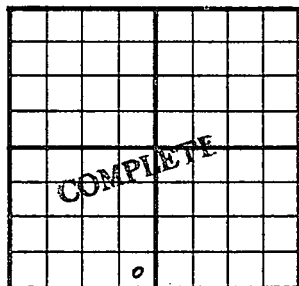

330 Ft. From S Line SW
330 Ft. From E Line Quarter
 Ist. Report NOV 7 1951
 Completion
 Remarks Ft. Zarah Pool
H & H - Contr.
 Spudding Date 9-23-51

Drlg. Data Oil well TD 3383
8" @ 190 Heeb. 2984 Br. lime 3099
Lans. 3113 Arb. 3365-71 5" @ 3366
TD 3383 S/.3 boph 1000 A S/ 12 boph
F/ 7 boph Comp. 140 bopd

J. E. TYRA