

Barton
19


KANSAS

12W

Sec. 30 Twp. R.

Well No. #12 Kohler Farm
W. L. Hartman Company
Hartman Contractor
Ft. Zarah Pool

Ft. from N. Line
450 Ft. from S. Line
Ft. from E. Line
800 Ft. from W. Line

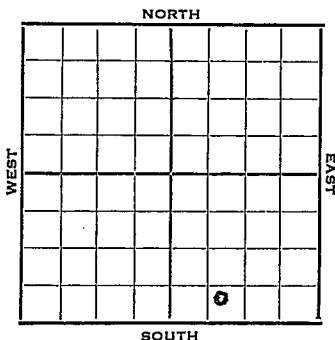

NW SE SW SE

1953

Elev. 1826' REPORT

7/8 Spud 7-3-53
8" @ 190
Drlg. 1774'

7/22 Top 2725, Heeb 2959, Tor 2982, Br li
3072, Lans 3088, B KC 3316, Arb 3336
RTD 3351
5" @ 3351'

7/29 NR

8/12 "

8/19 "

9/16 "

10/14 "

10/28 NR

11/4 "

11/11 Spud 7-3-53 Shut in gas well
TD 3351' 8" @ 190 Top 2725
Heeb 2959 Tor. 2982 Br lime 3073
Lans 3088' B KC 3316 Arb. 3336
TD 3351 5" @ 3351
Comp. for shut in gas well.

COMPLETED

