

Section 30 Township 19 Range 12 W

Well No. # 1 Harris "B"

Company National Assoc. Pet.

NORTH

	0						

WEST

EAST

SOUTH

27

Sec. 30 Twp. 19 R. 12W

Well No. #1 Harris "B" Farm

National Assoc. Pet. Company

Contractor


Ft. from N. Line

990' Ft. from S. Line

Ft. from E. Line

990' Ft. from W. Line

NE SW NW

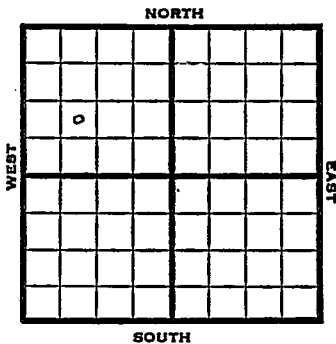

1951 Elev. 1831' REPORT

2/14 Cellar & Pits

6/2-0 Abandoned Location

ABANDONED

