

FORM 51 10M 2249 PETROL

KANSAS

Rush

Section 30 Township 19 Range 19N

Well No. 1 Knott

Company John Lindar

Wildcat

NORTH

WEST

EAST

							6

SOUTH

Rush

KANSAS

Sec. 30 Twp. 19 R. 19W ✓

Well No. #1 Knotts Farm

John Linder Company

Wildcat


330' Ft. from N. Line

Ft. from S. Line

330' Ft. from E. Line

Ft. from W. Line

NE/C

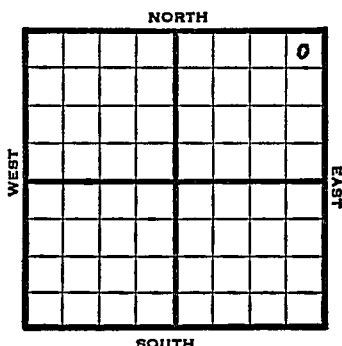

1949

Elev 2288' REPORT

7/20 Location

7/27 RUR

8/3 8" @ 160'

Drlg 2385'

8/10 Lansing 3838'

Drlg 3888'

8/17 Cong 4350'

Miss 4440'

Drlg 4620'

8/24 TD 4741'

Viola 4608'

Simp sd 4702'

Arb. 4711'

Aband.

ABANDONED

Kansas

Wildcat

Map No. _____ Sec. 30 Twp. 19 R. 19W

Well No. 1 Knotts

John Lindar

Company

Contractor

NE/C

FIRST REPORT
SECTION PLAT

330 Ft. from N. Line

Ft. from S. Line

330 Ft. from E. Line

Ft. from W. Line

Rush County

Location ✓

Rig up

Drilling and Remarks:

RECORD

Cased _____ in., _____ ft.

Sand _____

Gas _____

Oil _____

Total Depth _____

PRODUCTION

1st 24 hrs. Nat. _____

1st 24 hrs. after shot _____

Gas _____ Cu. Ft.

Dry Hole _____

Abandoned _____

Date

JUL 20 1949 19


S. J. LEWIS Scout

Kansas

Map No. K80 Sec. 30 Twp. 19 R. 19WWell No. 1 KnottsJohn Lindas Company**ABANDONED**

Contractor

NE/C

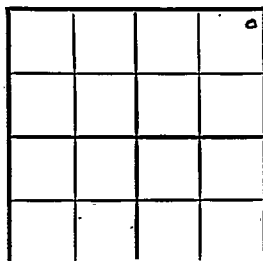E1, 2288
SECTION PLAT330 Ft. from N. Line Ft. from S. Line330 Ft. from E. Line Ft. from W. Line

Rush County

Location Rig up

Drilling and Remarks:

Vidco 4608Sing. Sol 4702Cor & 4711**RECORD**Cased in., ft.Sand Gas Oil Total Depth 4741**PRODUCTION**1st 24 hrs. Nat. 1st 24 hrs. after shot Gas Cu. Ft.Dry Hole Abandoned

Date

AUG 24 1949 19S. J. LEWIS Scout