


Section 31 Township 19 Range 11WWell No. " 1 Dick Est.Company Berwick-Spurill & Harms

NORTH

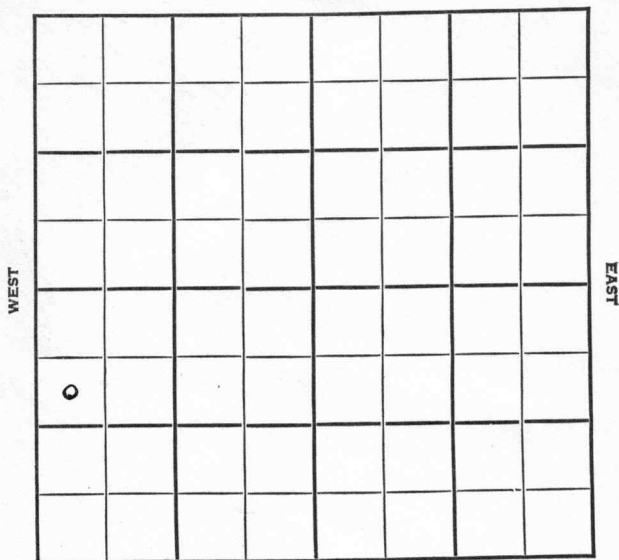

SOUTH

KANSAS

Barton

Sec. 31 Twp. 19 R. 11W

Well No. #1 Dick Est. Farm

Berwick-Spurill & Harms Company

Ellinwood


990 Ft. from N. Line

 Ft. from S. Line

 Ft. from E. Line

330 Ft. from W. Line

SW NW SW

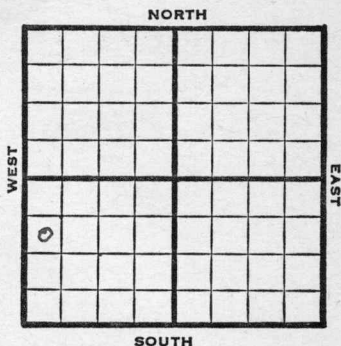

1948

Elev. 1790' REPORT

1/21

8" @ 145'
Drlg. 2770'

1/26

Lansing 3084'
Arbuckle 3347'-48'
TD 3348'
5" @ 3347'
RUST

2/4

TD 3352' - 250 acid.

2/11

Arb. 3347'
5" @ 3347'
250 acid
Pump 96 Pot
41.5 Gr.
TD 3352'
Comp.

COMPLETED

Map No. _____ Sec. 31 Twp. 19 R. 11W

Well No. 1 Dick Est.

Berwick-Spurill & Harms Company

FIRST REPORT Contractor

SW NW SW


SECTION PLAT

990 Ft. from N. Line

_____ Ft. from S. Line

_____ Ft. from E. Line

330 Ft. from W. Line

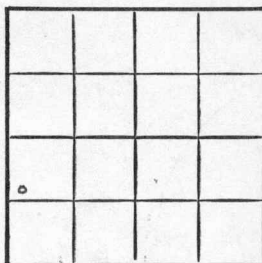

Barton County

Location _____

Rig up _____

Drilling and Remarks:

8" @ 145

drlg. 2770

RECORD

Cased _____ in., _____ ft.

Sand _____

Gas _____

Oil _____

Total Depth _____

PRODUCTION

1st 24 hrs. Nat. _____

1st 24 hrs. after shot _____

Gas _____ Cu. Ft.

Dry Hole _____

Abandoned _____

Date

JAN 21 1948

19

S. J. LEWIS

Scout

Kansas

Map No. 46 Sec. 31 Twp. 19 R. 11WWell No. 1 Dick Est.Berwick-Spurill & Harms Company


COMPLETE

Contractor

SW NW SW

E 11790

SECTION PLAT

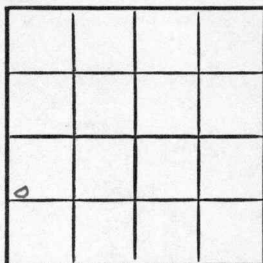990 Ft. from N. Line Ft. from S. Line Ft. from E. Line330 Ft. from W. LineBarton CountyLocation Rig up

Drilling and Remarks:

*Cur 3347**5" @ 3347**250 aciol**Pump 96 Bst**415 ft*

RECORD

Cased in., ft.Sand Gas Oil Total Depth 3352

PRODUCTION

1st 24 hrs. Nat. 1st 24 hrs. after shot Gas Cu. Ft.Dry Hole Abandoned

Date

*5-11-46 RUB**DEC 23 1947*

19

S. J. LEWIS

Scout