


Section 31 Township 19 Range 11W

Well No. #3 Dick

Company Harms, Inc.

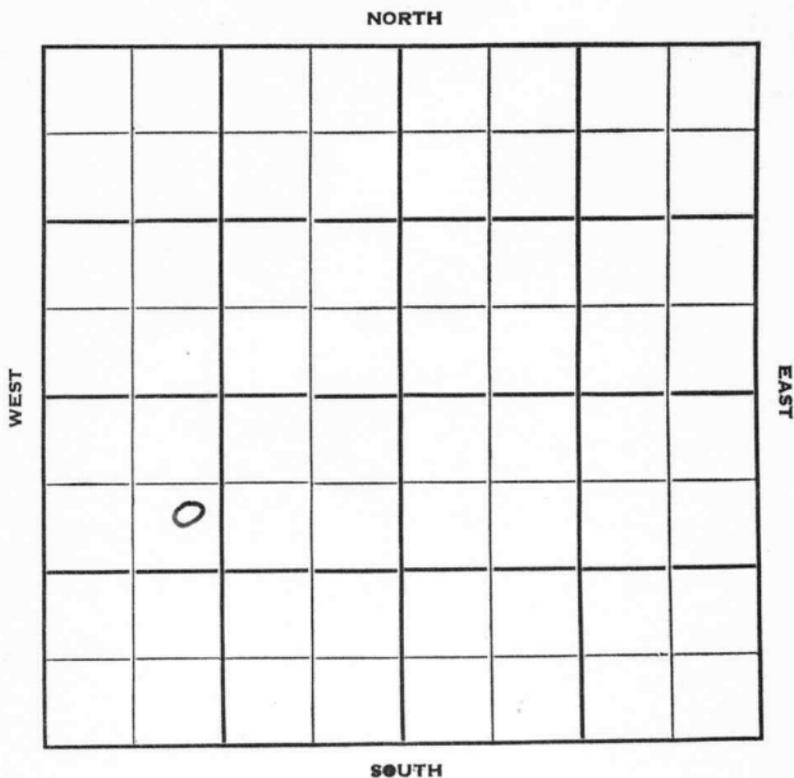

Sec. 31 Twp. 19 R. 11W

Well No. #3 Dick Farm

Harms, Inc. Company

Harms & Knight - Contr. Contractor


860' Ft. from N. Line

_____ Ft. from S. Line

_____ Ft. from E. Line

1000' Ft. from W. Line

SE NW SW/4

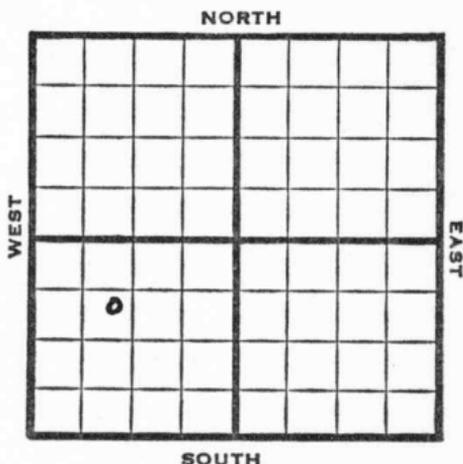

1952 Elev. 1793' REPORT

7/16	Spud 7-11-52 8" @ 310 Drlg. 1890
7/23	Heeb. 2948 Br Li 3061 Lans. 3082 Arb. 3341 SO RTD 334 5" @ 3343'
7/30	NR
8/6	CO 3344' 2 Boph DD 3346, no increase DD 3349 fill up 1600' fluid trace wtr.
8/13	NR
8/20	"
8/27	"
9/3	"
9/10	"
9/17	"
9/24	"
10/1	Spud 7-11-52 Oil Well TD 3349 8" @ 310' Heeb. 2948 Br Li 3061 Lans. 3082 Arb. 3341 TD 3344 5" @ 3343 CO to 3344 2 boph DD 3346 No inc. DD 3349 FU 1600' fluid Comp. 40 bopd

COMPLETED


County Barton State Kansas

Sec. 31 (Blk. 19 (Sur. Rge.) 11W Map No.

Operator Harms Inc.

Well No. 3 Farm Dick

Elev. _____ Location SE NW SW/4

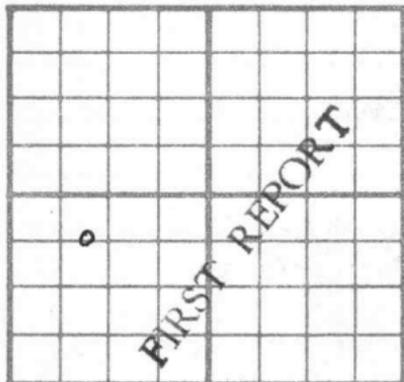

860 Ft. From N Line SW

1000 Ft. From W Line Quarter

1st. Report JUL 16 1952

Completion _____

Remarks _____

Harms & Knight - Contr.

Spudding Date 7-11-52

Drlg. Data _____

8" @ 310 Drlg. 1890

J. G. McGEHEE

