


Section 31 Township 19 Range 11W

Well No. #1 Yancey

Company Hulme Drlg.

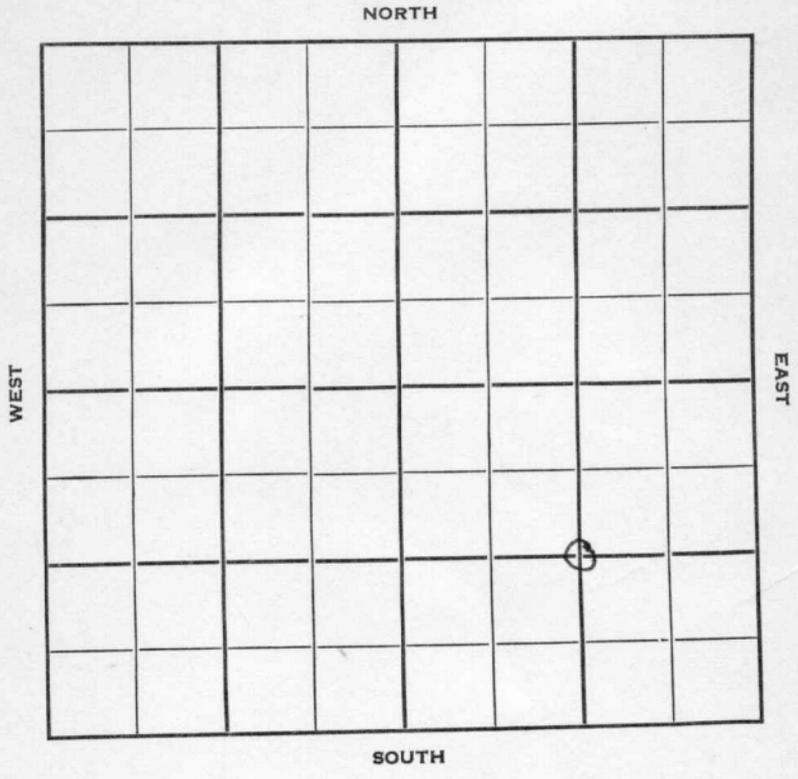

Barton

KANSAS

11W

Sec. 31 Twp. 19 R.

Well No. #1 Yancey Farm

Hulme Drlg. Company

Contractor

Ft. from N. Line

1320'


Ft. from S. Line

1320

Ft. from E. Line

Ft. from W. Line

SE 1/4 C SE/4

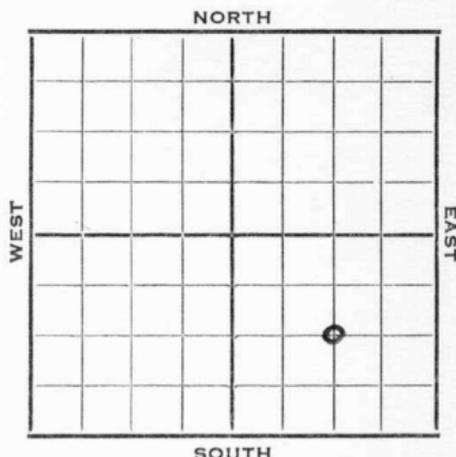

1952

Elev. 1786' REPORT

10/22

Spud 10-15-52
8" @ 309'
Shut Down @ 2218'

10/29

D&A

11/5

Spud 10-15-52
D&A TD 3367' 8" @ 309'
Heeb. 2960 Br Li 3079
Lans. 3092
DST 3138-65 open 1 hr. rec. 5' mud
Cong. 3354
TD 3367' D&A

ABANDONED


County Barton State Kansas

Sec. 31 (Blk. 19) (Sur. 11W) (Twp.) (Rge.) Map No.

Operator Hulme Drlg.

Well No. 1 Farm Yancey

Elev. _____ Location C SE/4

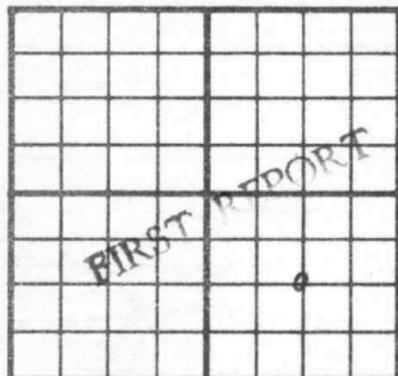

1320 Ft. From S Line SE

1320 Ft. From E Line Quarter

1st. Report OCT 22 1952

Completion _____

Remarks _____

Spudding Date 10-15-52

Drlg. Data _____

8" @ 309 shut down @ 2218

