


Map No. KANSAS Sec. 31 Twp. 19 R. Rice 10W
 Well No. 6-Granger Farm
Phillips & I.T.O. Company

NORTH

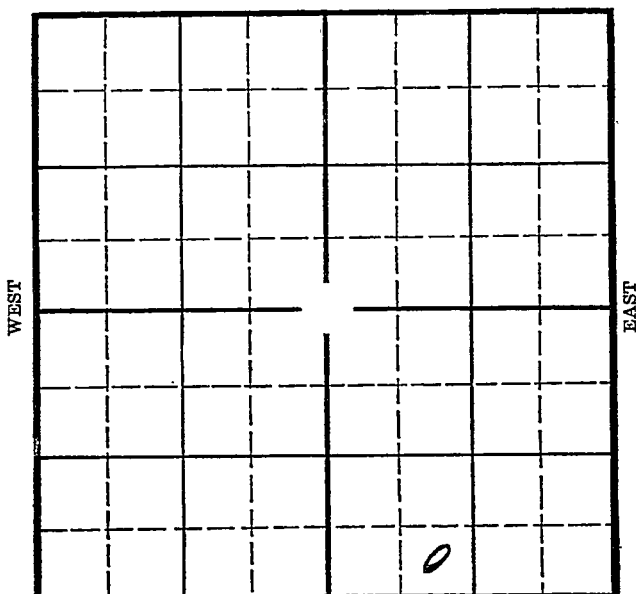

SOUTH

SPECIAL

Location _____

Drilling Remarks _____

Rig Up _____

Drilling Remarks _____

RECORD

Cased _____ in. _____ ft.

Sand _____

Gas _____

Oil _____

Total Depth _____

PRODUCTION

1st 24 hrs. Nat. _____

1st 24 hrs. after shot _____

Gas _____ cu. ft. _____

Dry Hole _____

Abandoned _____


Rice
KANSAS 31 19 10^W
Map No. Sec. Twp. R.
Well No. 6 - *Kranpe* Farm
Phillips & I.T.O. Company

Ft. from N. Line

330 Ft. from S. Line

Ft. from E. Line

990 Ft. from W. Line

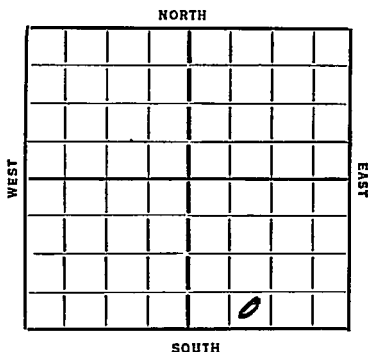

Special

Date	Elev.	REPORT
1935	1797	
9/27		Row up.
10/3	560	12" 205
10/10	3075	"
11/1		Cemented back to 2000
11/7	2615	"
11/14	2766	"
11/21	3145	"
11/29	3306	TD 3310 Rust
12/6	3326-33	TD
"	1750	Oil 7 hrs
"		R. tubing & rods.
12/11	3306	Top Sil
"	3332	TD
"	396	Pot

COMPLETED

KANSAS

Form 28 - Jan 1925 - 9-26

Map No. 46 Sec. 31 Twp. 19 R. 10WWell No. 6-15-rampPhillips + ITIO Company

Contractor

FIRST REPORTS

SECTION PLAT

Ft. from N. Line

330 Ft. from S. Line

Ft. from E. Line

990 Ft. from W. Line

Special

Location

Rig up

Drilling and Remarks:

Rig up

RECORD

Cased.....in.,ft.

Sand.....

Gas.....

Oil.....

Total Depth.....

PRODUCTION

1st 24 hrs. Nat.....

1st 24 hrs. after shot.....

Gas.....Cu. Ft.

Dry Hole.....

Abandoned.....

Date

9-27-35 192ORVAL MANNSCHRECK
Scout

KANSAS

Map No. 46 Sec. 31 Twp. 19 R. 10W

Well No. 6 - Krump

Phillips & I. T. I. Co. Company

Contractor

SECTION PLAT

Ft. from N. Line

330 Ft. from S. Line

Ft. from E. Line

990 Ft. from W. Line

COMPLETED

Location

Rig up

Drilling and Remarks:

RECORD

Cased _____ in., _____ ft.

Sand 1 sil 330.6

Gas _____

Oil _____

Total Depth 333.2

PRODUCTION

1st 24 hrs. Nat. _____

1st 24 hrs. after shot _____

Gas _____ Cu. Ft.

Dry Hole _____

Abandoned _____

Rot. 396

Date

12-11-35 192 Scout

ORVAL MANNSCHRECK