

KANSAS


Rice

Form 51-5M-4-36-Palace

Section 31 Township 19 Range 10-W

Well Number #12-Krampe

Company Phillips

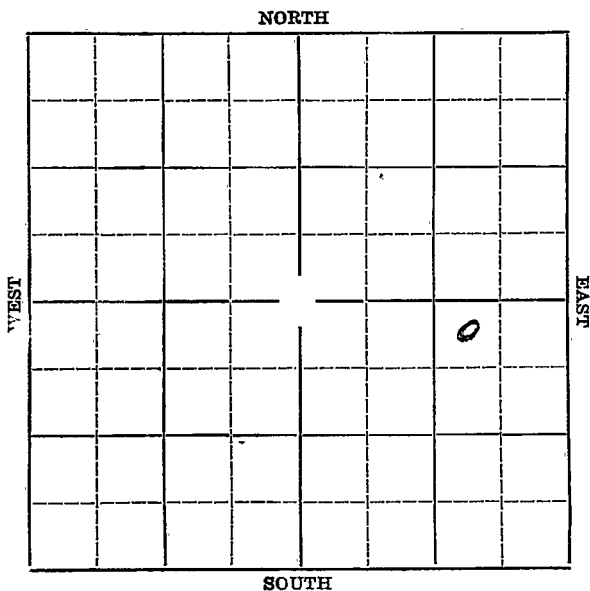

KANSAS

Rice

Sec. 31 Twp. 19 R. 10W

Well No. #12 Krampe Farm


Phillips. _____ Company

330' Ft. from N. Line

Ft. from S. Line

990' Ft. from E. Line

Ft. from W. Line

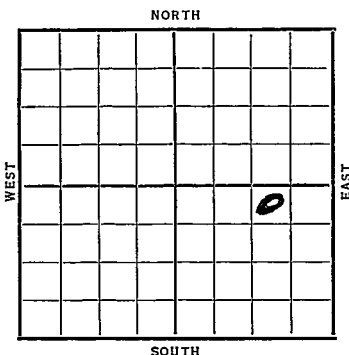[illegible]

*Rice***KANSAS**Map No. 46 Sec. 31 Twp. 19 R. 10WWell No. 12 Krampe.Phillips Company

Contractor

SECTION PLAT

			0

330 Ft. from N. Line

_____ Ft. from S. Line

990 Ft. from E. Line

_____ Ft. from W. Line

FIRST REPORT

Location _____

Rig up _____

Drilling and Remarks:

12" @ 200 WOC**RECORD**

Cased _____ in., _____ ft.

Sand _____

Gas _____

Oil _____

Total Depth _____

PRODUCTION

1st 24 hrs. Nat. _____

1st 24 hrs. after shot _____

Gas _____ Cu. Ft.

Dry Hole _____

Abandoned _____

Date

SEP 30 1936

19

S. J. LEWIS

Scout

KANSAS

Map No. 46 Sec. 31 Twp. 19 R. 10WWell No. 12 KrampePhillips Company

Contractor

SECTION PLAT

			6

380 Ft. from N. Line

_____ Ft. from S. Line

990 Ft. from E. Line

_____ Ft. from W. Line

COMPLETED

Location _____

Rig up _____

Drilling and Remarks:

Si 3284932 oil
trace water

RECORD

Cased _____ in., _____ ft.

Sand _____

Gas _____

Oil _____

Total Depth 3290

PRODUCTION

1st 24 hrs: Nat. _____

1st 24 hrs. after shot _____

Gas _____ Cu. Ft.

Dry Hole _____

Abandoned _____

Date

NOV 10 1936 19

S. J. LEWIS Scout