


Section 31 Township 19 Range 10-W

Well Number 11-Krampe

Company Phillips

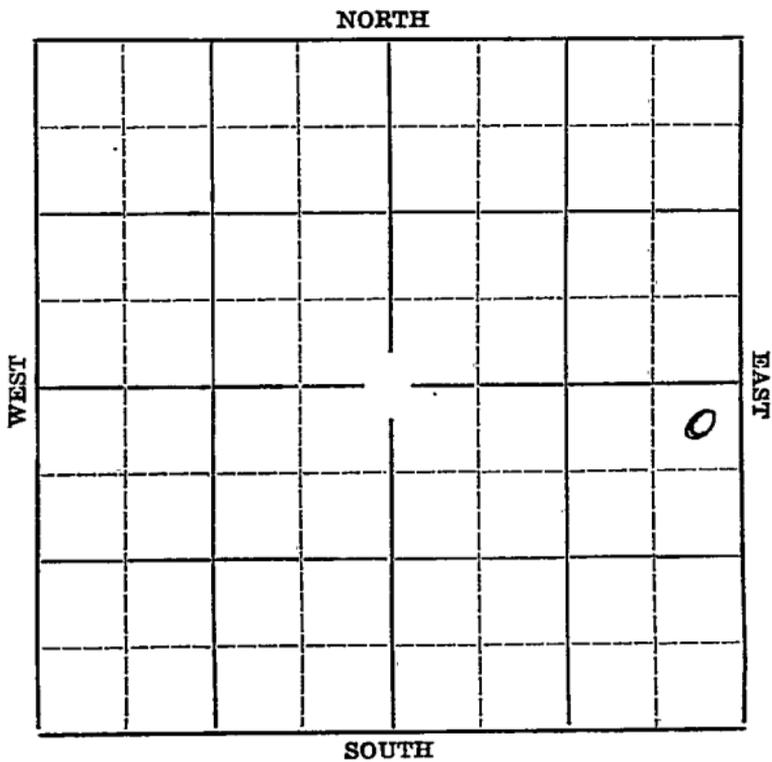

KANSAS

Map No. \_\_\_\_\_ Sec. 31 Twp. 19 R. 10W

Well No. #11 Krampe Farm \_\_\_\_\_

Phillips Company


NORTH

330' Ft. from N. Line

\_\_\_\_\_ Ft. from S. Line

330' Ft. from E. Line

\_\_\_\_\_ Ft. from W. Line

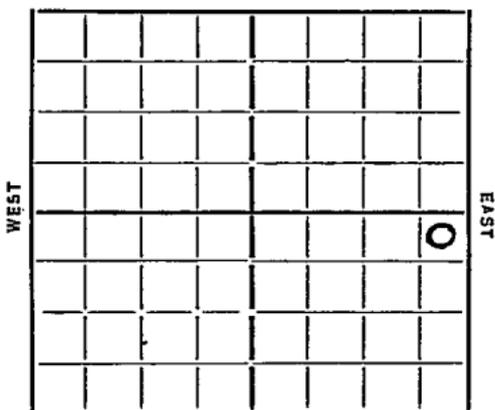

Elev. 1788

SOUTH

Date  
1936

REPORT

5/6 Location.

5/14 Spud.

5/21 Drlg. 710'.

5/28 Drlg. 2995'.

6/4 Sil. 3275'. Drlg. 3285'. H.F.O.

6/10/36-Sil. 3275'.

Total depth 3285'.

1686 bbls natural.

**COMPLETED**

Map No. 46 Sec. 31 Twp. 19 R. 10 W

Well No. 11 Krampke

Phillips Company

Contractor

SECTION PLAT

330 Ft. from N. Line

..... Ft. from S. Line

330 Ft. from E. Line

..... Ft. from W. Line

			o

FIRST REPORT

Location ✓

Rig up .....

Drilling and Remarks:

RECORD

Cased.....in., .....ft.

Sand.....

Gas.....

Oil.....

Total Depth.....

PRODUCTION

1st 24 hrs. Nat.....

1st 24 hrs. after shot.....

Gas.....Cu. Ft.

Dry Hole.....


Abandoned.....

Date

MAY 6 1936 192

S. J. LEWIS

Scout

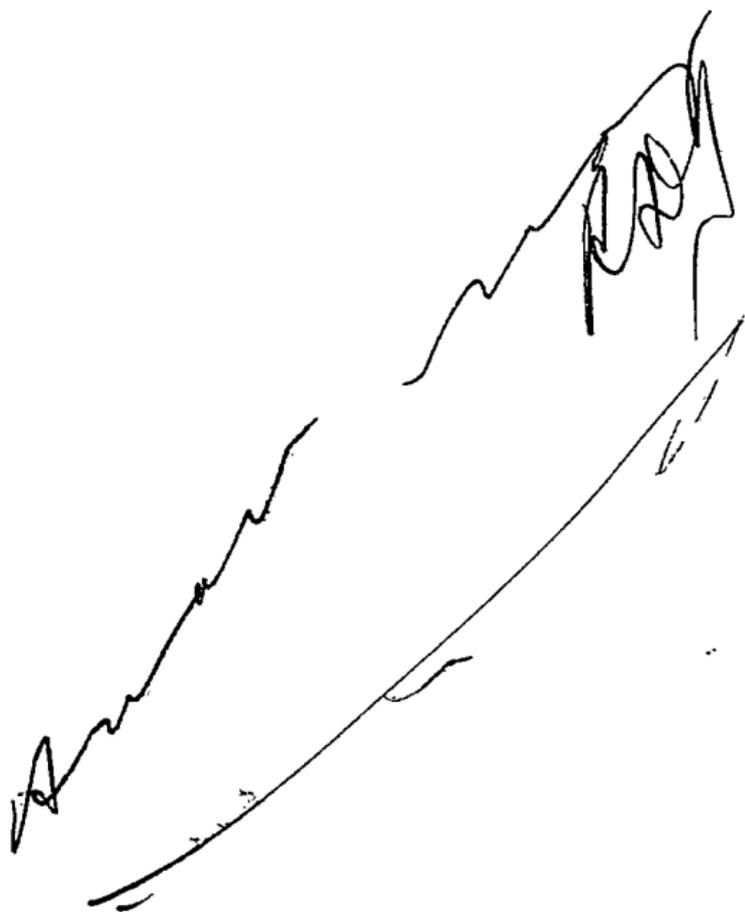

Returned	
Cards	<i>Ch</i>
Tracing	<i>Ch</i>
France	<i>Ch</i>
Scarborough	<i>Ch</i>
Moody	<i>Ch</i>
Scarborough Plat Book	
Moody Plat Book	

Map No. <sup>46</sup> **KANSAS** Sec. 31 Twp. 19 R. 10W

Well No. 11 Kramer

Phillips Company

Contractor

**SECTION PLAT**

320 Ft. from N. Line

\_\_\_\_\_ Ft. from S. Line

330 Ft. from E. Line

\_\_\_\_\_ Ft. from W. Line

			0

**COMPLETED**

Location \_\_\_\_\_

Rig up \_\_\_\_\_

Drilling and Remarks:

Si 53275

1686 Nat.

**RECORD**

Cased \_\_\_\_\_ in., \_\_\_\_\_ ft.

Sand \_\_\_\_\_

Gas \_\_\_\_\_

Oil \_\_\_\_\_

Total Depth 328

**PRODUCTION**

1st 24 hrs. Nat. \_\_\_\_\_

1st 24 hrs. after shot \_\_\_\_\_

Gas \_\_\_\_\_ Cu. Ft.

Dry Hole \_\_\_\_\_

Abandoned \_\_\_\_\_

Date

**JUN 10 1936**

19

**S. J. LEWIS**

Scout

*[Handwritten signature]*

Returned	<i>[Signature]</i>
Cards	<i>[Signature]</i>
Tracing	<i>[Signature]</i>
France Map	<i>[Signature]</i>
Scarborough Map	<i>[Signature]</i>
Moody Map	<i>[Signature]</i>
Scarborough Plat Book	<i>[Signature]</i>
Moody Plat Book	<i>[Signature]</i>