


Map No. **KANSAS** Sec. **31** Twp. **19** R. **10^W**
 Well No. **6-Heckel** Farm
Gypsy Oil Company

NORTH

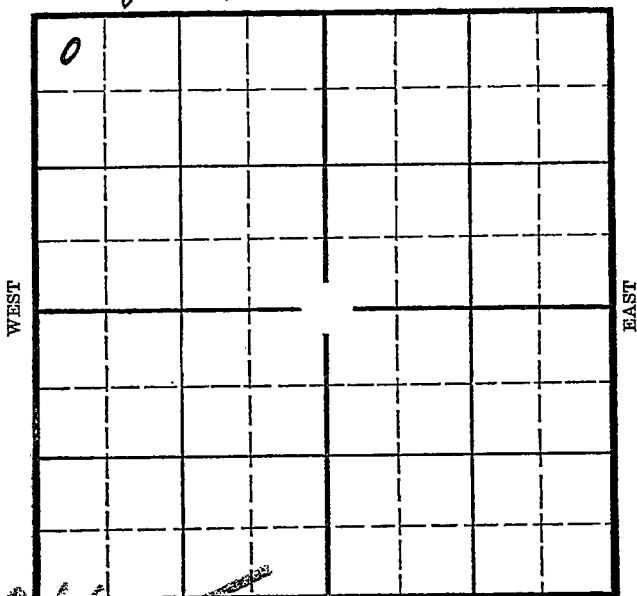

SOUTH

Offset
 Location
 Drilling Remarks

Rig Up
 Drilling Remarks

RECORD

Cased _____ in. _____ ft.
 Sand _____
 Gas _____
 Oil _____
 Total Depth _____

PRODUCTION

1st 24 hrs. Nat. _____
 1st 24 hrs. after shot _____
 Gas _____ cu. ft. _____
 Dry Hole _____
 Abandoned _____




Ft. from S. Line

Ft. from E. Line

330 Ft. from W. Line

offset

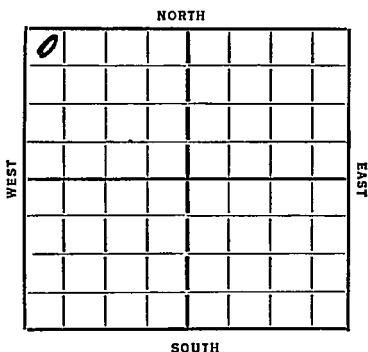

REPORT

1946 Elev. 1766 REPORT

1/29 Rig Cellar
2/7 Blot Rig
2/14 Blg 700 10" 157
2/21 " 2386
2/28 " 3260
3/6 Top Dil 3282 1/2 7" 3283
TD 3303
600' Dil 3/4 hrs
2300' Dil 15 hrs
Rung Tubg
3/13 864 Bbls Dil 14 hrs on pot
3/18 Pot 1499 Bbls Dil (24)
3/18 Dil 3282 1/2
TD 3303
1000 acid
1449 Bbls.

COMPLETED

KANSAS

Map No. 46 Sec. 31 Twp. 19 R. 10WWell No. 6-SteckelSydney-oil Company

Contractor

FIRST REPORTS

330 Ft. from N. Line

Ft. from S. Line

Ft. from E. Line

330 Ft. from W. Lineoffset

Location

Rig up

Drilling and Remarks:

Dig Cellar

SECTION PLAT

0			

RECORD

Cased.....in.,ft.

Sand.....

Gas.....

Oil.....

Total Depth.....

-PRODUCTION

1st 24 hrs. Nat.....

1st 24 hrs. after shot.....

Gas.....Cu. Ft.

Dry Hole.....

Abandoned.....

Date

ORVAL MANNSCHEIDT

1-29-36 192.....Scout

KANSAS

Map No. 46 Sec. 31 Twp. 19 R. 10W

Well No. 6 - F E, Steele

Gypsy Company

Contractor

COMPLETED

SECTION PLAT

330 Ft. from N. Line

..... Ft. from S. Line

..... Ft. from E. Line

330 Ft. from W. Line

0			

diag. offset to our #1 matzek.

Location.....

Rig up.....

Drilling and Remarks:

1000 acid

1449 bbls

RECORD

Cased..... in oil 3282 1/2 ft.

Sand.....

Gas.....

Oil..... 3303

Total Depth.....

PRODUCTION

1st 24 hrs. Nat.....

1st 24 hrs. after shot.....

Gas..... Cu. Ft.

Dry Hole.....

Abandoned.....

Date

MAR 18 1936

ORVAL MANNSCHRECK

192

Scout