

Map No.

KANSAS

Sec.

31

Twp.

19

R.

Rice
10W

Well No.

4 F. E. Steckel
Supply Oil Co.

Farm

Company

NORTH

WEST

EAST

SOUTH

Location

Drilling Remarks

Rig Up

Drilling Remarks

RECORD

Cased _____ in. _____ ft.

Sand _____

Gas _____

Oil _____

Total Depth _____

PRODUCTION

1st 24 hrs. Nat. _____

1st 24 hrs. after shot _____

Gas _____ cu. ft.

Dry Hole _____

Abandoned _____

Rice


KANSAS
Map No. _____ Sec. 31 Twp. 19 R. 10W
Well No. 4 - F. E. Steckel Farm
Gypsy oil Co Company

_____ Ft. from N. Line

660 Ft. from S. Line

_____ Ft. from E. Line

990 Ft. from W. Line

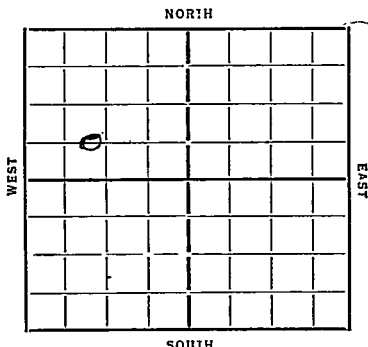

Elev. 1773

Date 1935

REPORT

8/7 Cellar
8/15 Dlg 600 12" 161
8/22 " 2945
8/23 Siliceous ~~3285~~ 3288
Core 3275-85
Small saturation 3284-85
Rung 7" 3281 (Zel)
8/29 Ruck
9/3 Correction: 3287
Top siliceous ~~3288~~ T 3300
Shal 495 Bbls oil 7 1/2 hrs (Zel)
9/12 Sil 3287
T 3300
1606 Bbls.

COMPLETED

KANSAS

Map No. 46 Sec. 31 Twp. 19 R. 10W

Well No. 4 - F.E. Steepel

happy oil Company

Contractor

COMPLETED

SECTION PLAT

Ft. from N. Line

660 Ft. from S. Line

Ft. from E. Line

990 Ft. from W. Line

0			

Location

Rig up

Drilling and Remarks:

1606 fph

RECORD

Cased in. ft.

Sand sil 3287

Gas

Oil

Total Depth 3300

PRODUCTION

1st 24 hrs. Nat.

1st 24 hrs. after shot

Gas Cu. Ft.

Dry Hole

Abandoned

Date

DEVAL MANN FIRECK

9-12-35 192

Scout

Map No. 4 Sec. 31 Twp. 19 R. 10W

Well No. 4 - F. E. Steckel

Hyper Oil Co Company

Contractor

FIRST REPORTS

Ft. from N. Line

660 Ft. from S. Line

Ft. from E. Line

990 Ft. from W. Line

SECTION PLAT

o			

Location

Rig up

Drilling and Remarks:

cellar

RECORD

Cased in, ft.

Sand

Gas

Oil

Total Depth

PRODUCTION

1st 24 hrs. Nat.

1st 24 hrs. after shot

Gas Cu. Ft.

Dry Hole

Abandoned

Date

8-7-35 192

ORVAL MANSCHE Scout