

Rice

Map No. KANSAS Sec. 31 Twp. 19 R. 10 W


Well No. 3-Steckel Farm _____
Gypsy Oil Co. Company _____

_____ Ft. from N. Line

660 Ft. from S. Line

330 Ft. from E. Line

_____ Ft. from W. Line

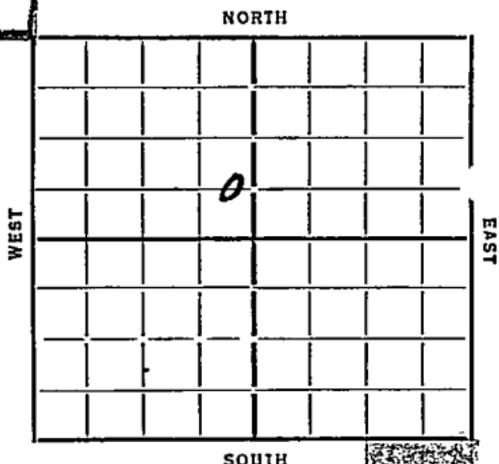

Date 1935

REPORT

- 5/8 Rst Rig
- 5/16 17" 153 WOC
- 5/23 Alg 2450
- 5/29 BB @ 3110 8" 3255
- 6/6 Alg cement
- 6/12 Alg 3343 - 3350
170 ft.

ABANDONED

Map No. 46 Sec. 31 Twp. 19 R. 10W

Well No. 3- Stuckel

Kypsy Oil Company

Contractor

ABANDONED

SECTION PLAT

		0	

Ft. from N. Line

660

Ft. from S. Line

330

Ft. from E. Line

Ft. from W. Line

RECORD

Location

Cased _____ in., _____ ft.

Rig up

Sand oil 3343

Drilling and Remarks:

Gas _____

Oil _____

Total Depth 3350

NO + A

PRODUCTION

1st 24 hrs. Nat. _____

1st 24 hrs. after shot _____

Gas _____ Cu. Ft.

Dry Hole _____

Abandoned _____

Date

6-12-35

192

W. SCHRECK

Scout

Map No. 46 Sec. 31 Twp. 19 R. 10W

Well No. 3 - Steckel

Gypsy Oil Co Company

Contractor

FIELD REPORTS

SECTION PLAT



..... Ft. from N. Line

660 Ft. from S. Line

330 Ft. from E. Line

..... Ft. from W. Line

Location.....

Rig up.....

Drilling and Remarks:

Rot Rig

RECORD

Cased..... in.,

Sand.....

Gas.....

Oil.....

Total Depth.....

PRODUCTION

1st 24 hrs. Nat.....

1st 24 hrs. after shot.....

Gas..... Cu. Ft.

Dry Hole.....

Abandoned.....

Date

ORVAL MANNSCHRECK

5-8-35 192.....

Scout