

Map No.

Well No.

Sec.

Twp.

R.

Farm

Company

NORTH

WEST

EAST

SOUTH

Location

Drilling Remarks

Rig Up

Drilling Remarks

RECORD

Cased _____ in. _____ ft.

Sand _____

Gas _____

Oil _____

Total Depth _____

PRODUCTION

1st 24 hrs. Nat. _____

1st 24 hrs. after shot _____

Gas _____ cu. ft. _____

Dry Hole _____

Abandoned _____



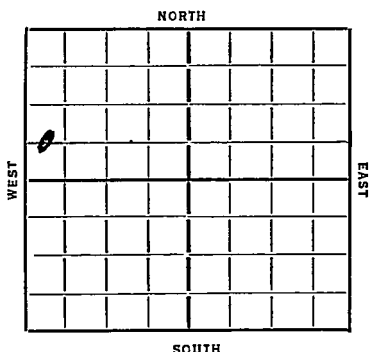
Ft. from N. Line

660 Ft. from S. Line

Ft. from E. Line

330 Ft. from W. Line

Elev. 1765

Date: 1/27/68 REPORT

Date	REPORT
1935	
12/23	Ring
12/36	TD 155 Net 10"
1/10	Alg 2320
1/17	Coring 3294
1/24	T Sil 3281 7" 3281
1/29	TD 3293 2800' OTH Coring
	Sil 3281
	TD 3301
	1464 Bole

COMPLETED

Map No. 46 Sec. 31 Twp. 19 R. 10W

Well No. 5-Steckel

Hyess oil Company

Contractor

FIRST REPORTS

SECTION PLAT

Ft. from N. Line

660 Ft. from S. Line

Ft. from E. Line

330 Ft. from W. Line

o			

Location ✓

Rig up

Drilling and Remarks:

Rig

RECORD

Cased in., ft.

Sand

Gas

Oil

Total Depth

PRODUCTION

1st 24 hrs. Nat.

1st 24 hrs. after shot

Gas Cu. Ft.

Dry Hole

Abandoned

Date

DEVAL MANNSCHRECK

12-23-32 192 Scout

Map No. 46 Sec. 31 Twp. 19 R. 10WWell No. 5-SteckelGypsy oil Company

Contractor

COMPLETE

SECTION PLAT

Ft. from N. Line

660 Ft. from S. Line

Ft. from E. Line

330 Ft. from W. Line

Location

Rig up

Drilling and Remarks:

1464 bbls

RECORD

Cased in, ft.

Sand oil 3281

Gas

Oil

Total Depth 3301

PRODUCTION

1st 24 hrs. Nat.

1st 24 hrs. after shot

Gas Cu. Ft.

Dry Hole

Abandoned

Date

ORVAL MANNSCHRECK

1-29-36 192 Scout