


Map No. _____ Sec. 31 Twp. 19 R. 10^w
 Well No. 3- Ranger Farm _____
C. B. Davis Company _____

NORTH

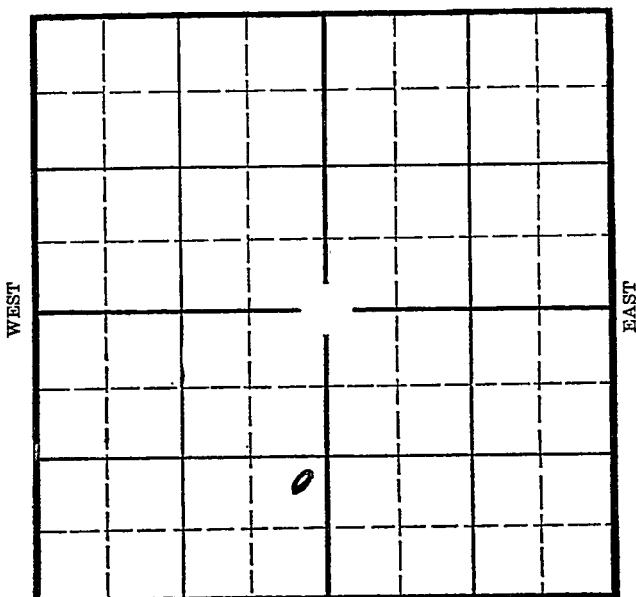

SOUTH

Location _____

Drilling Remarks _____

Rig Up _____

Drilling Remarks _____

RECORD

Cased _____ in. _____ ft.

Sand _____

Gas _____

Oil _____

Total Depth _____

PRODUCTION

1st 24 hrs. Nat. _____

1st 24 hrs. after shot _____

Gas _____ cu. ft.

Dry Hole _____

Abandoned _____

Rice

Map No. KANSAS Sec. 31 Twp. 19 R. 10^W


Well No. 3- denser Farm
C. B. Davis Company

 Ft. from N. Line

117² Ft. from S. Line

330 Ft. from E. Line

 Ft. from W. Line

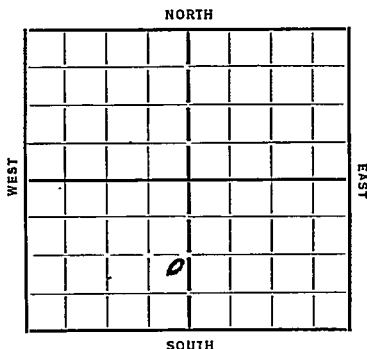

Elevation 1786

Date 1935 REPORT

6/19 Rotary
6/28 — 7/6 — 7/11 —
7/18 226 run 12"
8/8 5" 3270 Sil 3278
8/5 T7 3297 Rust
8/5 HFO.
8/22 Hly plug T7 3298
8/22 HFO 3 hrs pumped water
8/29 2000 acid
9/4 Sil 3278
T7 3298
2000 acid
615 Blk.

COMPLETED

Map No. 46 Sec. 31 Twp. 19 R. 10WWell No. 3-DenverC. B. Davis Company

Contractor

COMPLETED**SECTION PLAT**

Ft. from N. Line

117 Ft. from S. Line330 Ft. from E. Line

Ft. from W. Line

Location

Rig up

Drilling and Remarks:

2000 and615 lbs**RECORD**

Cased _____ in. _____ ft.

Sand 3278

Gas _____

Oil _____

Total Depth 3298**PRODUCTION**

1st 24 hrs. Nat. _____

1st 24 hrs. after shot _____

Gas _____ Cu. Ft.

Dry Hole _____

Abandoned _____

Date

9-4-35 192**ORVAL MANNSCH** Scout

Map No. 46 Sec. 31 Twp. 19 R. 10WWell No. 3-Deuser
C. B. Davis Company

Contractor


FIRST REPORTS

Ft. from N. Line

1172 Ft. from S. Line330 Ft. from E. Line

Ft. from W. Line

SECTION PLAT

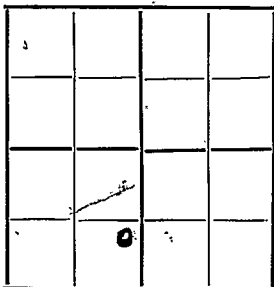

Location

Rig up

Drilling and Remarks:

Rotary

RECORD

Cased _____ in., _____ ft.

Sand _____

Gas _____

Oil _____

Total Depth _____

PRODUCTION

1st 24 hrs. Nat. _____

1st 24 hrs. after shot _____

Gas _____ Cu. Ft.

Dry Hole _____

Abandoned _____

Date

ORIGINAL RECORD

6-19-35 192 _____ Scout