

Map No.

KANSAS

Sec

31

Twp.

19

R.

Rice
10 W


Well No.

4-
C. B. Davis et al

Farm

Company

NORTH

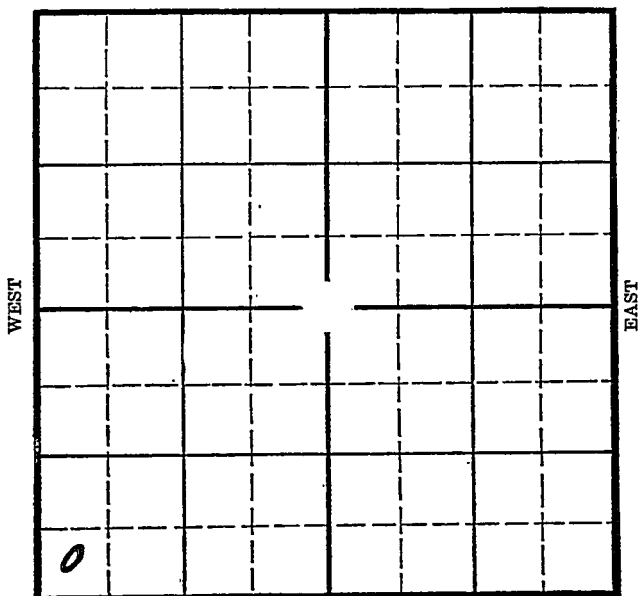

SOUTH

Location

Drilling Remarks

Rig Up

Drilling Remarks

RECORD

Cased _____ in. _____ ft.

Sand _____

Gas _____

Oil _____

Total Depth _____

PRODUCTION

1st 24 hrs. Nat. _____

1st 24 hrs. after shot _____

Gas _____ cu. ft. _____

Dry Hole _____

Abandoned _____

Map No. KANSAS Sec. 31 Twp. 19 R. 10W
Well No. 4- Dwyer Farm
C. B. Davis et al Company


 Ft. from N. Line

330 Ft. from S. Line

 Ft. from E. Line

330 Ft. from W. Line

Elev. 1763

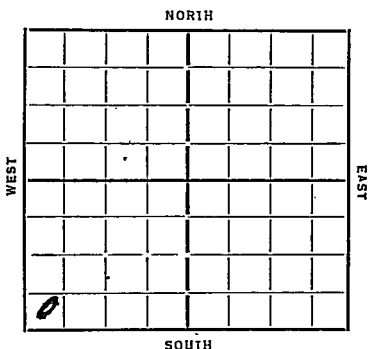

Date	REPORT
7/10	Material
7/18	Rig
8/8	Sil 3268 T2 3270
8/15	7" 3268 Rust
8/22	CO 3280 2900' 2 hrs
8/29	Tubg 706 Blbs 21 hrs 1500 acid
9/4	Sil 3268
	T2 3273
	1500 acid
	851 Blbs.

COMPLETED

Map No. 46 Sec. 31 Twp. 19 R. 10W

Well No. 4-Dwiser

C. B. Davis et al Company

Contractor

FIRST REPORTS

SECTION PLAT

.....Ft. from N. Line

330 Ft. from S. Line

.....Ft. from E. Line

330 Ft. from W. Line

Location.....

Rig up.....

Drilling and Remarks:

RECORD

Cased.....in.,ft.

Sand.....

Gas.....

Oil.....

Total Depth.....

PRODUCTION

1st 24 hrs. Nat.....

1st 24 hrs. after shot.....

Gas.....Cu. Ft.

Dry Hole.....

Abandoned.....

Date

7-10-35 192

ORVAL MANNSCHRECK

Scout

Map No. 46 Sec. 31 Twp. 19 R. 10WWell No. 4-HenryC. B. Davis et al Company

Contractor


COMPLETED

SECTION PLAT

Ft. from N. Line

330 Ft. from S. Line

Ft. from E. Line

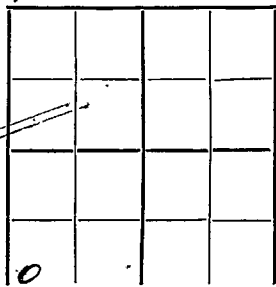330 Ft. from W. Line

Location

Rig up

Drilling and Remarks:

1500 and851 lbs

RECORD

Cased in. ft.

Sand Sil 3268

Gas

Oil

Total Depth 3273

PRODUCTION

1st 24 hrs. Nat.

1st 24 hrs. after shot

Gas Cu. Ft.

Dry Hole

Abandoned

Date

ORVAL MANNSCHRECK

9-4-35 192

Scout