

Map No.

Sec.

Typ.


R.

Well No.

Farm

Company

NORTH

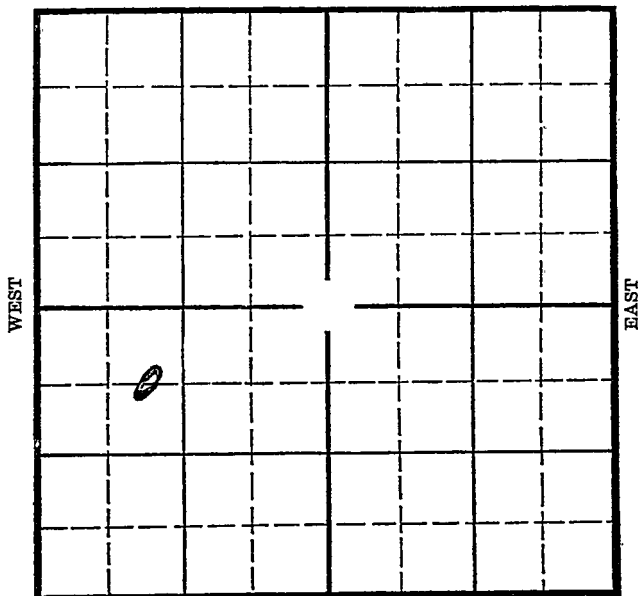

SOUTH

Location

Drilling Remarks

Rig Up

Drilling Remarks

RECORD

Cased _____ in. _____ ft.

Sand _____

Gas _____

Oil _____

Total Depth _____

PRODUCTION

1st 24 hrs. Nat. _____

1st 24 hrs. after shot _____

Gas _____ cu. ft. _____


Dry Hole _____

Abandoned _____

Rice

Map No. *1745* Sec. *31* Twp. *19* R. *10W*
Well No. *6- Deuser* Farm
C. B. Davis Company

660 Ft. from N. Line
Ft. from S. Line
Ft. from E. Line
990 Ft. from W. Line
Elev. 1783

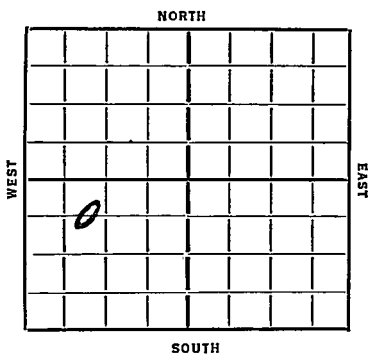

Date *1935* REPORT
9/12 Spunk
10/3 2940
10/10 Lil 3278 7" 3278 Rice
10/24 Lil 3278
Lil 3292-97
TD 3297
1062 Blw.

COMPLETED

Map No. 46 Sec. 31 Twp. 19 R. 10^W

Well No. 6-Denver
C. B. Davis Company

Contractor

FIRST REPORTS

SECTION PLAT

660 Ft. from N. Line

_____ Ft. from S. Line

_____ Ft. from E. Line

990 Ft. from W. Line

Location _____

Rig up _____

Drilling and Remarks:

Spud

RECORD

Cased _____ in., _____ ft.

Sand _____

Gas _____

Oil _____

Total Depth _____

PRODUCTION

1st 24 hrs. Nat. _____

1st 24 hrs. after shot _____

Gas _____ Cu. Ft.

Dry Hole _____

Abandoned _____

Date

9-12-35 192 ORVAL MANNSCHRECK Scout

Map No. 4 Sec. 31 Twp. 19 R. 10W

Well No. 6-Dewser

C. B. Davis Company

Contractor

COMPLETED


SECTION PLAT

660 Ft. from N. Line

..... Ft. from S. Line

..... Ft. from E. Line

990 Ft. from W. Line

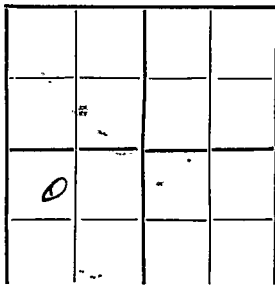

Location.....

Rig up.....

Drilling and Remarks:

1062 bbls

RECORD

Cased..... in.,..... ft.

Sand sil 3278

Gas.....

Oil 3292-97

Total Depth 3297

PRODUCTION

1st 24 hrs. Nat.....

1st 24 hrs. after shot.....

Gas..... Cu. Ft.

Dry Hole.....

Abandoned.....

Date

10-24-35 192.....

VAL MANNSCHRECK

Scout