




Company

NORTH

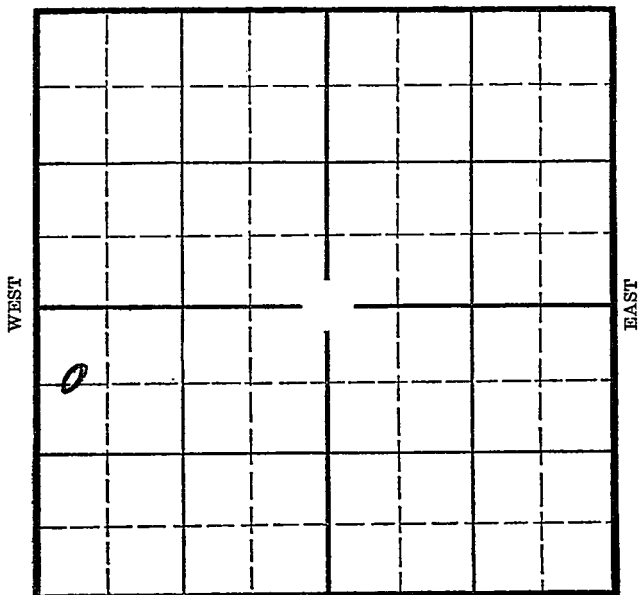

SOUTH

Location_____

Drilling Remarks

Rig Up_____

Drilling Remarks

RECORD

Cased _____ in. _____ ft.

Sand

Gas

Oil_____

Total Depth_____

PRODUCTION

1st 24 hrs. Nat. _____

1st 24 hrs. after shot_____

Gas.....cu. ft.

Dry Hole

Abandoned

KANSAS

Map No. 31 Sec. 19 Twp. 10^WWell No. 7- Oscar FarmDavis et al

Company

NORTH

660

Ft. from N. Line

Ft. from S. Line

Ft. from E. Line

330

Ft. from W. Line

WEST

EAST

Elev. 1770

SOUTH

REPORT

1/9/36
 2/5 Entry Met on ground
 2/14 RR
 2/21
 2/28 Rgn
 3/6 Dr" 131 dly cement
 3/13 dly 2390
 3/20 Drlg. 3254.
 3/27 T.D. 3259 Pipe collapsed @ 2550⁴⁵
 fishing.
 4/2 Pulled damaged pipe and resetting.
 4/10 Skidding.rig.
 4/16 12" @ 118' Drlg. 385'
 4/23 Drlg. 2200'
 4/30 Drlg. 3236'
 5/7 Sil. 3267'. T.D. 3270'. Set 7".
 Rigging up standard tools.
 5/14 Testing.
 5/20/36- Sil. 3267'.
 T.D. 3284'.
 1220 Nat. Pot.

COMPLETED

KANSAS

Map No. 46 Sec. 31 Twp. 19 R. 10W

Well No. 7 - Dueser

Davis et al Company

Contractor

SECTION PLAT

660 Ft. from N. Line

.....Ft. from S. Line

.....Ft. from E. Line

330 Ft. from W. Line

0			

FIRST REPORT

Location.....

Rig up.....

Drilling and Remarks:

*Rotary mat
on ground*

RECORD

Cased.....in.,ft.

Sand.....

Gas.....

Oil.....

Total Depth.....

PRODUCTION

1st 24 hrs. Nat.....

1st 24 hrs. after shot.....

Gas.....Cu. Ft.

Dry Hole.....

Abandoned.....

Date

FEB 5 1936

ORVAL MANNSCHRECK

.....192.....Scout

KANSAS

Map No. 46 Sec. 31 Twp. 19 R. 10WWell No. 7 TurnerTavis et al. Company

Contractor

SECTION PLAT

0			

660 Ft. from N. Line

_____ Ft. from S. Line

_____ Ft. from E. Line

330 Ft. from W. Line

COMPLETED

Location _____

Rig up _____

Drilling and Remarks:

Sic 632671220 NaXPoX.

RECORD

Cased 1 in., _____ ft.

Sand _____

Gas _____

Oil _____

Total Depth 3284

PRODUCTION

1st 24 hrs. Nat. _____

1st 24 hrs. after shot _____

Gas _____ Cu. Ft.

Dry Hole _____

Abandoned _____

Date

MAY 20 1936S. J. LEWIS

Scout