

RICE


Form 51-5M-3-35-Mid-West

Map No. **KANSAS** Sec. **31** Twp. **19** R. **10-W**

Well No. **8-Dueser** Farm

C.B. Davis et al Company

NORTH

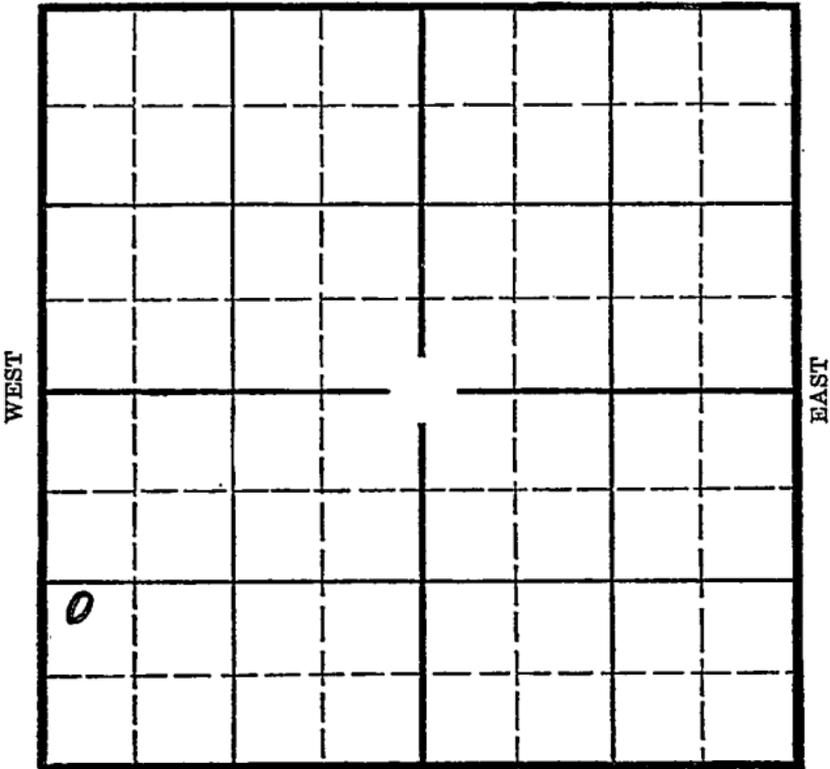

SOUTH

Location _____
Drilling Remarks _____

Rig Up _____
Drilling Remarks _____

RECORD

PRODUCTION

Cased _____ in. _____ ft.
 Sand _____
 Gas _____
 Oil _____
 Total Depth _____

1st 24 hrs. Nat. _____
 1st 24 hrs. after shot _____
 Gas _____ cu. ft. _____
 Dry Hole _____
 Abandoned _____

Rice

Map No. KANSAS Sec. 31 Twp. 19 R. 10W

Well No. 8-Queen Farm
C. B. Davis et al Company


_____ Ft. from N. Line

1158 Ft. from S. Line

_____ Ft. from E. Line

330 Ft. from W. Line

Elev. 1763

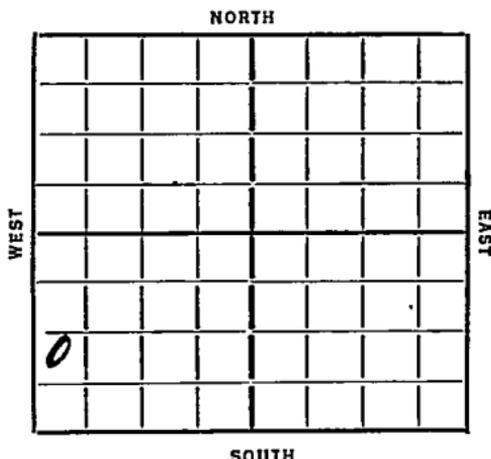

REPORT

~~1936~~
1936

3/11 Cellar

3/20 Rotary Rig.

3/27 12" - 111 WOC

4/2 Drlg. 2350'

4/10 Sil. 3268' - T.D. 3269' run 6"

4/16 Sil. 3259' T.D. 3261' Rust.

4/23 T.D. 3278'

4/29/36 Sil. 3259

T.D. 3278'

2000 acid.

1148 Potential.

COMPLETED

Map No. 46 Sec. 31 Twp. 19 R. 10^W

Well No. J. Quiser

C. B. Davis et al Company

Contractor

FIRST REPORTS

SECTION PLAT

..... Ft. from N. Line

1158 Ft. from S. Line

..... Ft. from E. Line

330 Ft. from W. Line

| | | | |
|--|--|--|--|
| | | | |
| | | | |
| | | | |
| | | | |
| | | | |
| | | | |
| | | | |
| | | | |

Location.....

Rig up.....

Drilling and Remarks:

cellar

RECORD

Cased.....in.,ft.

Sand.....

Gas.....

Oil.....

Total Depth.....

PRODUCTION

1st 24 hrs. Nat.....

1st 24 hrs. after shot.....

Gas.....Cu. Ft.

Dry Hole.....

Abandoned.....

Date

3-11-36 192.....

ORVAL MANNSCHRECK

Scout

Map No. 46 Sec. 21 Twp. 19 R. 10WWell No. J. GuesseHarris & Co. Company

Contractor

SECTION PLAT

| | | | |
|--|--|--|--|
| | | | |
| | | | |
| | | | |
| | | | |
| | | | |

..... Ft. from N. Line

1158 Ft. from S. Line

..... Ft. from E. Line

330 Ft. from W. Line

COMPLETED

RECORD

Location.....

Cased..... in., ft.

Rig up.....

Sand.....

Drilling and Remarks:

Gas.....

Oil.....

Total Depth 3275

PRODUCTION

1st 24 hrs. Nat.....

1st 24 hrs. after shot.....

Gas..... Cu. Ft.

Dry Hole.....

Abandoned.....

Date

APR 29 1936

192

LEWIS

Scout