


Rice

Form 51-5M-4-36-Palace

Section 31 Township 19 Range 10-W

Well Number 9-Dueser

Company C.Davis et al

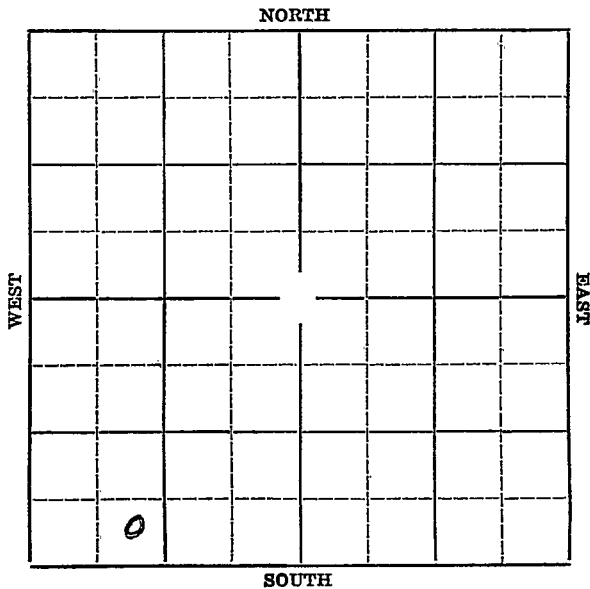

**KANSAS**  
Map No. \_\_\_\_\_ Sec. 31 Twp. 19 R. 10-W  
Well No. 9-Dueser Farm \_\_\_\_\_  
C. Davis et al Company \_\_\_\_\_


\_\_\_\_\_ Ft. from N. Line

330 Ft. from S. Line

\_\_\_\_\_ Ft. from E. Line

990 Ft. from W. Line

Elev. 1769

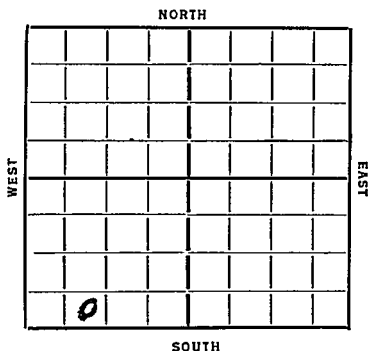Date  
1936

## REPORT

4/22 R.O.G.  
4/30 --  
5/7 12" @ 114' W.O.C.  
5/14 Drlg. 2240'.  
5/21 Drlg. 3258'.  
5/28 Sil. 3274'. 7" @ 3274½'. T.D.  
3276'. R.U.S.T.  
6/4 Shut down.  
6/11 T.D. 3298'. 1500' oil. Clean out.  
6/17/36-Sil. 3274'.  
~~Rate~~ T.D. 3298'.  
Potential 786 bbls oil  
**COMPLETED**

KANSAS

*Rice*  
 Map No. 46 Sec. 31 Twp. 19 R. 10N

Well No. 9 Thresher

C. Davis et al Company

Contractor

## SECTION PLAT

Ft. from N. Line

320 Ft. from S. Line

Ft. from E. Line

990 Ft. from W. Line

|  |  |  |  |
|--|--|--|--|
|  |  |  |  |
|  |  |  |  |
|  |  |  |  |
|  |  |  |  |
|  |  |  |  |

## FIRST REPORT

Location

Rig up

Drilling and Remarks:

*ROG*

## RECORD

Cased in., ft.

Sand

Gas

Oil

Total Depth

## PRODUCTION

1st 24 hrs. Nat.

1st 24 hrs. after shot

Gas Cu. Ft.

Dry Hole

Abandoned

Date

APR 22 1936

192

S. J. LEWIS

Scout

KANSAS

Map No. 46 Sec. 31 Twp. 19 R. 10W

Well No. 9 Dweller

Harris & Co Company

Contractor

SECTION PLAT

|  |  |  |  |
|--|--|--|--|
|  |  |  |  |
|  |  |  |  |
|  |  |  |  |
|  |  |  |  |

\_\_\_\_\_ Ft. from N. Line

330 Ft. from S. Line

\_\_\_\_\_ Ft. from E. Line

990 Ft. from W. Line

COMPLETED

Location \_\_\_\_\_

Rig up \_\_\_\_\_

Drilling and Remarks:

Sil 3274

RECORD

Cased \_\_\_\_\_ in., \_\_\_\_\_ ft.

Sand \_\_\_\_\_

Gas \_\_\_\_\_

Oil \_\_\_\_\_

Total Depth 3298

PRODUCTION

1st 24 hrs. Nat. \_\_\_\_\_

1st 24 hrs. after shot \_\_\_\_\_

Gas \_\_\_\_\_ Cu. Ft.

Dry Hole \_\_\_\_\_

Abandoned \_\_\_\_\_

Date

JUN 17 1936

19

S. J. LEWIS Scout