


Map No. **KANSAS** Sec. *31* Twp. *19* R. *10^w*

Well No. *J. Krampke* Farm
Phillips & I.T.O. Company

Rice

NORTH

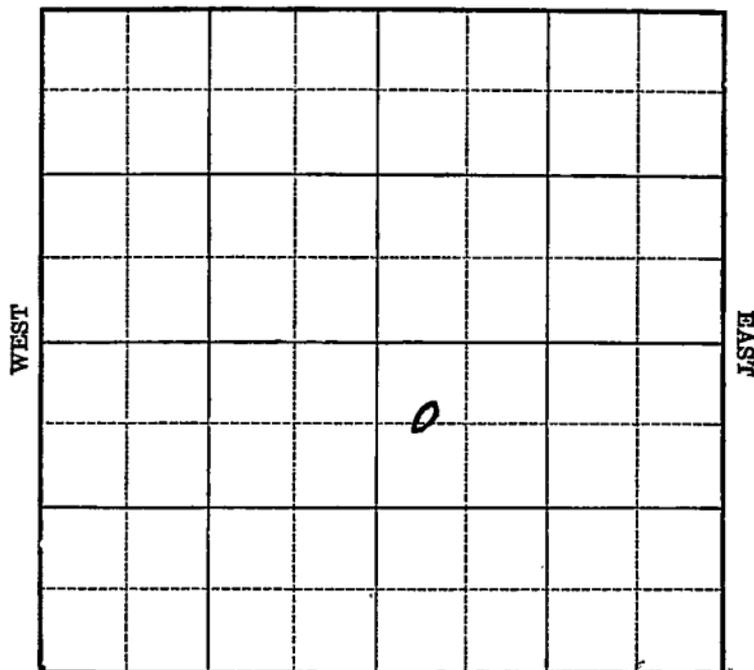

SOUTH

Location _____

Drilling Remarks _____

Rig Up _____

Drilling Remarks _____

RECORD

Cased _____ in. _____ ft.

Sand _____

Gas _____

Oil _____

Total Depth _____

PRODUCTION

1st 24 hrs. Nat. _____

1st 24 hrs. after shot _____

Gas _____ cu. ft.

Dry Hole _____


Abandoned _____

Rice

Map No. 4 ANSAS Sec. 31 Twp. 19 R. 10^W

Well No. 1-Krampke Farm
Phillips & I.T.I.O. Company

660 Ft. from N. Line
 Ft. from S. Line
 Ft. from E. Line
330 Ft. from W. Line

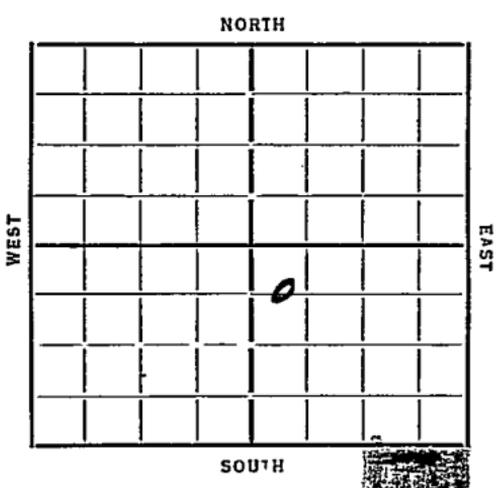

Date 1935 REPORT

3/20 Location
3/28 Bldg.
4/4 15" 221
4/14 Bldg 2660 6" 3285
4/16 Topped Siliceous lime 3285 3283
T¹⁷ 3288 with a show of
oil Rust (Telegram)
4/22 Topped Siliceous lime 3283
T¹⁷ 3301 3000 feet oil (Telegram)
4/26 Sil 3283 Corrected
T¹⁷ 3301 3100' oil 2 hrs
40 Min.
5/1 Pumped 1720 Bbls 24 hrs (Tel)
5/1 Sil 3283 T¹⁷ 3301
1720 Bbls Natural

COMPLETED

7/3 Made another test of 2147
Bbls oil 24 hrs on pump (Tel)

Map No. 46 Sec. 31 Twp. 19 R. 10W

Well No. 1 - K ramp

Phillips & ITI Company

COMPLETED Contractor

SECTION PLAT

660 Ft. from N. Line
..... Ft. from S. Line
..... Ft. from E. Line
330 Ft. from W. Line

		o	

Special

Location.....

Rig up.....

Drilling and Remarks:

1720 lbs
Natural

RECORD

Cased..... in., ft.
Sand Sil 3283
Gas.....
Oil.....
Total Depth 3301

PRODUCTION

1st 24 hrs. Nat.....
1st 24 hrs. after shot.....
Gas..... Cu. Ft.
Dry Hole.....
Abandoned.....

Date

5-1-35 192.....

ORVAL MANSCHRECK

Scout

Map No. 46 Sec. 31 Twp. 19 R. 10W

Well No. 1-Krampke

Phillips + ITIO Company

Contractor

FIRST REPORTS

SECTION PLAT

660 Ft. from N. Line

..... Ft. from S. Line

..... Ft. from E. Line

330 Ft. from W. Line

		0	

Location

Rig up

Drilling and Remarks:

RECORD

Cased..... in.,

Sand.....

Gas.....

Oil.....

Total Depth.....

PRODUCTION

1st 24 hrs. Nat.....

1st 24 hrs. after shot.....

Gas..... Cu. Ft.

Dry Hole.....

Abandoned.....

Date

3-20-35 192

ORVAL MANNSCHECK

Scout