


Rice

Map No. **KANSAS** Sec. *31* Twp. *19* R. *900*

Well No. *1 McFarland* Farm
Ramsey Company

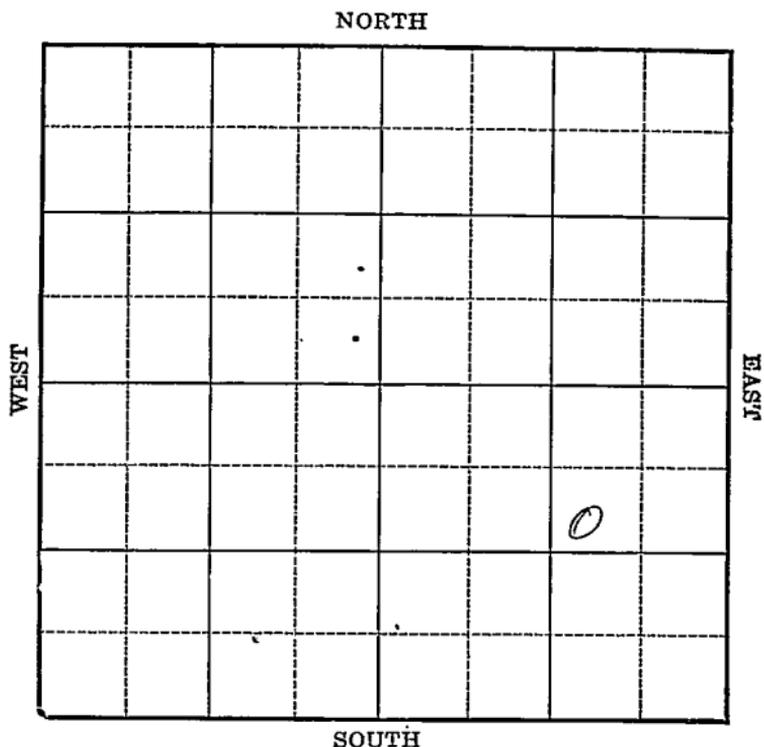

Location _____
Drilling Remarks _____

Rig Up _____
Drilling Remarks _____

RECORD

Cased _____ in. _____ ft.

Sand _____

Gas _____

Oil _____

Total Depth _____

PRODUCTION

1st 24 hrs. Nat. _____

1st 24 hrs. after shot _____

Gas _____ cu. ft. _____

Dry Hole _____

Abandoned _____

Rice

Map No. KANSAS Sec. 31 Twp. 19 R. 9W

Well No. 1-McFarland Farm


Ramsey et al Company

854 Ft. from N. Line

_____ Ft. from S. Line

830 Ft. from E. Line

_____ Ft. from W. Line

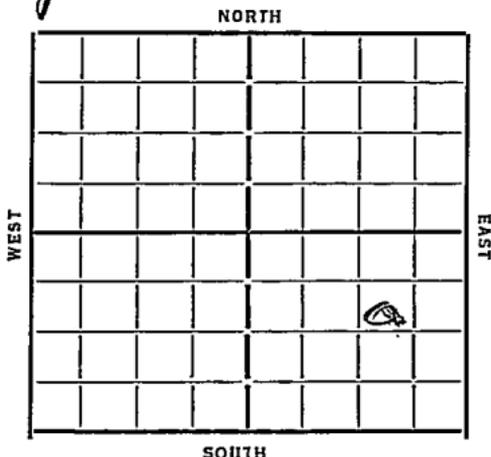

Date 1933

REPORT

9/27

location

10/15

10/11 — 10/18

10/25

11/1 — 11/8 — 11/15

11/22

11/29

12/6

Ponds

12/13

—

12/27

20" at 195 — 15" at 450

Wreg 930

1/11

8" at 2536

Wreg 2795

1/17

Show oil 2975

H.F.W 3000-3005

6" at 3008

S.O at 3035

1/24

Siliceous 3226. T.D. 3238

swab 20 ft in 5 hrs

Treating with 1000 gal acid

1/31

—

2/9

Siliceous 3226 TD 3244

1000 gal acid Pot 924 Bble 5% Neta

COMPLETED

Map No. Ruby 49 Sec. 31 Twp. 19 R. 9W

Well No. 1- Mc Harland

Ramsey et al Company

Contractor

SECTION PLAT

854 Ft. from N. Line

..... Ft. from S. Line

830 Ft. from E. Line

..... Ft. from W. Line

			o

FIRST REPORTS

Location

Rig up.....

Drilling and Remarks:

RECORD

Cased..... in., ft.

Sand.....

Gas.....

Oil.....

Total Depth.....

PRODUCTION

1st 24 hrs. Nat.....

1st 24 hrs. after shot.....

Gas..... Cu. Ft.

Dry Hole.....

Abandoned.....

Date SEP 27 1933

O. Manschuet Scout

Map No. 49 Sec. 31 Twp. 19 R. 9W

Well No. H McFarland

Ramsey et al Company

Contractor

COMPLETED

SECTION PLAT

854 Ft. from N. Line

..... Ft. from S. Line

830 Ft. from E. Line

..... Ft. from W. Line

			o

Location.....

Rig up.....

Drilling and Remarks:..

1000 gal acid

pot
924 lbs
590 W

RECORD ,

Cased..... in., ft.

Sand Silicious 3226

Gas.....

Oil.....

Total Depth 3226

PRODUCTION

1st 24 hrs. Nat.....

1st 24 hrs. after shot.....

Gas..... Cu. Ft.

Dry Hole.....

Abandoned.....

Date

2-9-34

192

O. Mammuch
Scout