

Rice


KANSAS

FORM 51 IOM 12-46 PETROL

Section 31 Township 19 Range 9W

Well No. 1 Obenhaus

Company Derby et al

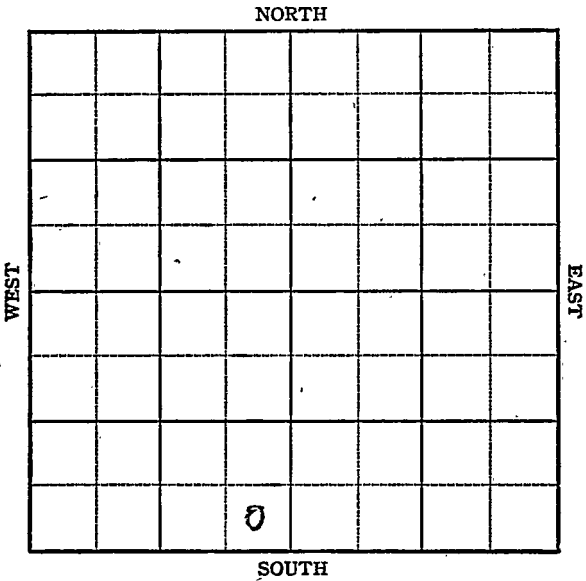


✓

Sec. 31 Twp. 19 **KANSAS** Rice R. 9-W

Well No. #1 Obenhaus Farm _____
Derby etal Company _____
Chase

_____ Ft. from N. Line
330 _____ Ft. from S. Line
330 _____ Ft. from E. Line
 _____ Ft. from W. Line

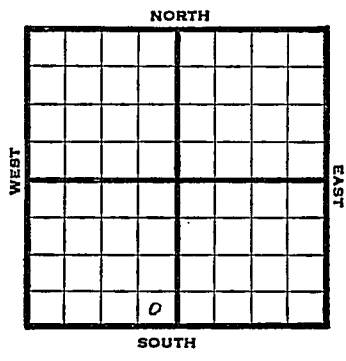

SE SW

1947 Elev. 1724' REPORT

5/14	8" @ 176' Drlg 1480'
5/20	Drlg 2920'
5/27	Lans 2929 Arb 3258-60 TD 3260
6/3	" "
6/10	" "
6/17	" "
6/24	" "
7/2	Arb. 3258' 5" @ 3259' 500 Acid Pump 100 Pot 41.7 Gr. TD 3262'

COMPLETED

