


Map No. **KANSAS** Sec. 31 Twp. 19 R. 9WWell No. 1 Obenhaus FarmCourtney Davis Company

NORTH

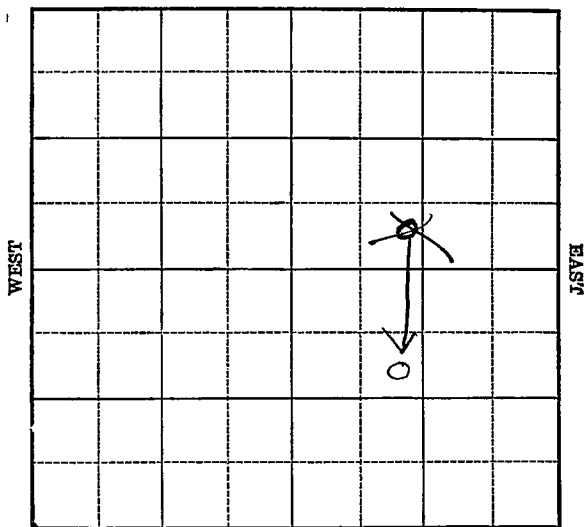

SOUTH

Location _____

Drilling Remarks _____

Rig Up _____

Drilling Remarks _____

RECORD

Cased _____ in. _____ ft.

Sand _____

Gas _____

Oil _____

Total Depth _____

PRODUCTION

1st 24 hrs. Nat. _____

1st 24 hrs. after shot _____

Gas _____ cu. ft.

Dry Hole _____

Abandoned _____

Rice

Map No. KANSAS Sec. 31 Twp 19 R. 9W

Well No. 1 Oberhaus Farm


Courtney Davis Company

944 Ft. from N. Line

450 Ft. from S. Line

_____ Ft. from E. Line

1007
1170 Ft. from W. Line

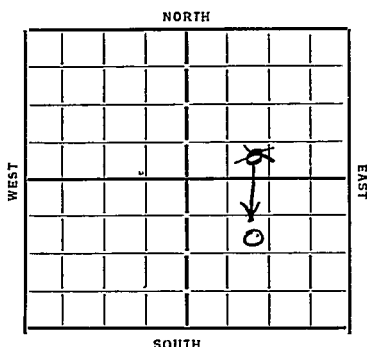

Date 1934

REPORT

6/6 Location
6/14 _____
6/21 Spud
6/28 dly 530 20" 201
7/5 " 1265
7/12 SD 1545
7/19 12" 1550 C.O.
7/26 dly 2115
8/2 " 2540
8/9 dly 2975 8" 2910
8/16 A.O. 3040 3250-52 500' oil
6" 3250 T Sil 3245
8/23 Pay 3250 -61"2 Pump 10 Bbls
per hr acidizing
8/30 Pump 20 Bbls per hr.
after acid
9/5 Siliceous 3245 TD 3261 1/2
1000 gal acid 300 Bbls.

COMPLETED

Map No. 49 Sec. 31 Twp. 19 R. 9W

Well No. 1 - Obenhaus

Courtney Davis Company

Contractor

CORRECTION

SECTION PLAT

944 Ft. from N. Line

_____ Ft. from S. Line

_____ Ft. from E. Line

1007 Ft. from W. Line

		0	

CORRECTION

RECORD

Location _____

Rig up _____

Drilling and Remarks: _____

Cased _____ in., _____ ft.

Sand _____

Gas _____

Oil _____

Total Depth _____

PRODUCTION

1st 24 hrs. Nat. _____

1st 24 hrs. after shot _____

Gas _____ Cu. Ft.

Dry Hole _____

Abandoned _____

Date

6-13-34 19

ORVAL MANNSCHRECK Scout

*Formerly reported
in N & H*

KANSAS

Map No. 49 Sec. 31 Twp. 19 R. 9WWell No. 1- OpenhausCourtney Davis Company

Contractor

FIRST REPORTS

SECTION PLAT

 Ft. from N. Line450 Ft. from S. Line Ft. from E. Line1120 Ft. from W. LineLocation ✓Rig up

Drilling and Remarks:

RECORD

Cased in., ft.Sand Gas Oil Total Depth

PRODUCTION

1st 24 hrs. Nat. 1st 24 hrs. after shot Gas Cu. Ft.Dry Hole Abandoned

Date

6-6-37

19


Scout

KANSAS

Form 26—LM Bks.—2-29

Map No. 49 Sec. 31 Twp. 19 R. 9WWell No. 1- OpenhandCourtney Davis Company

Contractor

COMPLETED

SECTION PLAT

944 Ft. from N. Line

_____ Ft. from S. Line

_____ Ft. from E. Line

1007 Ft. from W. Line

Location _____

Rig up _____

Drilling and Remarks:

1000 gal acid300 lbs

RECORD

Cased _____ in., _____ ft.

Sand siliceous 3245

Gas _____

Oil _____

Total Depth 3261 ✓

PRODUCTION

1st 24 hrs. Nat. _____

1st 24 hrs. after shot _____

Gas _____ Cu. Ft.

Dry Hole _____

Abandoned _____

Date

9-5-37 19

ORVAL MANNSCHRECK

Scout