

Rice

W

49 KANSAS

Map No. _____ Sec. 31 Twp. 19 R. 9

Well No. 1 Rose

E. F. Jones & Co Company

Contractor

FIRST REPORTS

_____ Ft. from N. Line

1170 Ft. from S. Line

150 Ft. from E. Line

_____ Ft. from W. Line

SECTION PLAT

9 acres

Location

Rig up _____

Drilling and Remarks:

RECORD

Cased _____ in., _____ ft.

Sand _____

Gas _____

Oil _____

Total Depth _____

PRODUCTION

1st 24 hrs. Nat. _____

1st 24 hrs. after shot _____

Gas _____ Cu. Ft.

Dry Hole _____

Abandoned _____

Date

APR 26 1933

CHAS. L. SHERWOOD

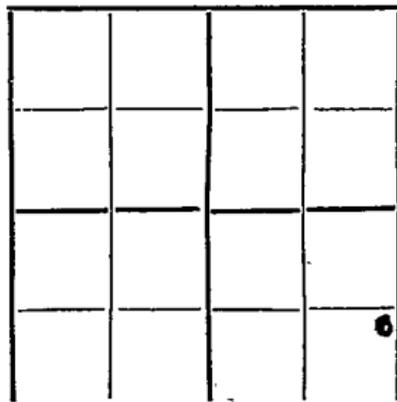
192

Scout

Rice
 Map No. _____ Sec. *31* Twp. *19* R. *9W*
49
 Well No. *1-Rose*
E. F. Jones et al Company
 Contractor

SECTION PLAT

_____ Ft. from N. Line
1170 Ft. from S. Line
150 Ft. from E. Line
 _____ Ft. from W. Line

**COMPLETED**

Location _____

Rig up _____

Drilling and Remarks:

*Silicious 3220**2400 fbls*

RECORD

Cased _____ in., _____ ft.

Sand _____

Gas _____

Oil _____

Total Depth *3224*

PRODUCTION

1st 24 hrs. Nat. _____

1st 24 hrs. after shot _____

Gas _____ Cu. Ft.

Dry Hole _____

Abandoned _____

Date

7/12/33 192 *Royal Mansfield*