


Rice

KANSAS

Form 51-5M-11-31-Palace

Map No. _____ Sec. 31 Twp. 19 R. 9W

Well No. #2 Rose Farm _____
E. F. Jones Company

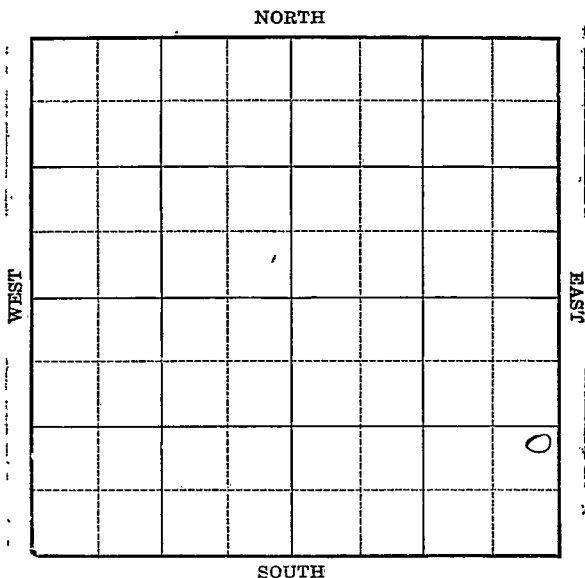

Location _____

Drilling Remarks _____

RECORD

Cased _____ in. _____ ft.

Sand _____

Gas _____

Oil _____

Total Depth _____

Rig Up _____

Drilling Remarks _____

PRODUCTION

1st 24 hrs. Nat. _____

1st 24 hrs. after shot _____

Gas _____ cu. ft.

Dry Hole _____

Abandoned _____

Rice

KANSAS

Form 252-A
5M 4-32 MPC

Map No. _____ Sec. 31 Twp. 19 R. 9W


Well No. 2 - Rose Farm
E. F. Jones Company

_____ Ft. from N. Line

1174 Ft. from S. Line

450 Ft. from E. Line

_____ Ft. from W. Line

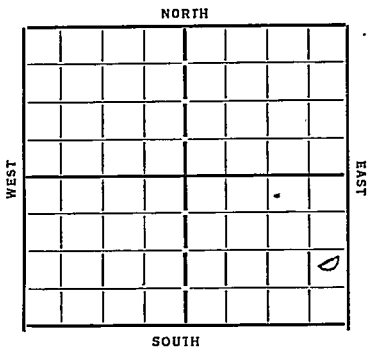

Date
1933

REPORT

8/9 Bldg Rig
8/17 —
8/23 —
8/30 —
9/6 run 12" at 315. wces
9/13 shlg 2100
9/20 8" - 3195 - 10,00.
9/29 TD 3195 RUST
10/5 —
10/11 Pipe cased at 3217 TD
10/18 6" at 3200'
10/25 fresh pipe
11/1 Top Sil 3224 T.D 3227
 2500' oil in 12 hrs
11/8 — 11/15 — 11/22 —
11/29 — 12/6 — 12/13 - 12/27 —
1/11 — 1/17 — 1/24 — 1/31 —
2/7 — 2/14 - 2/23 — 3/1 —
3/8 — 3/15 — 3/22 - 3/29 —
4/5 — 4/12 — 4/19 — 4/26 —
5/3 — 5/10 — 5/18 - 5/25 —
5/31 — 6/7 —

- OVER -

6/13 Siliceous 3294 TD 3227
400 Bbls.

COMPLETED

Map No. 49 Sec. 31 Twp. 19 R. 9W

Well No. #2 - Rose

E. H. Jones Company

Contractor

SECTION PLAT

..... Ft. from N. Line

1170 Ft. from S. Line

450 Ft. from E. Line

..... Ft. from W. Line

			●

FIRST REPORTS

Location.....

Rig up.....

Drilling and Remarks:

B. R.

RECORD

Cased..... in., ft.

Sand.....

Gas.....

Oil.....

Total Depth.....

PRODUCTION

1st 24 hrs. Nat.....

1st 24 hrs. after shot.....

Gas..... Cu. Ft.

Dry Hole.....

Abandoned.....

Date

8/9/33 192 O. Mannschick Scout

no wall map

Returned	
Cards	<i>AB</i>
Tracing	<i>AB</i>
France Map	<i>X</i>
Scarborough Map	<i>X</i>
Moody Map	<i>X</i>
Scarborough Plat Book	
Moody Plat Book	

Map No. 49 Sec. 31 Twp. 19 R. 9W

Well No. 2-Rose

E. F. Jones Company

Contractor

**COMPLETED
ABANDONED**

SECTION PLAT

			0

_____ Ft. from N. Line

1170 Ft. from S. Line

450 Ft. from E. Line

_____ Ft. from W. Line

Location _____

Rig up _____

Drilling and Remarks:

400 lbs

RECORD

Cased _____ in., _____ ft.

Sand silicious 3224

Gas _____

Oil _____

Total Depth 3227

PRODUCTION

1st 24 hrs. Nat. _____

1st 24 hrs. after shot _____

Gas _____ Cu. Ft.

Dry Hole _____

Abandoned _____

Date

6-13-37 19

ORVAL MANNSCHRECK

Scout

pool
no

Returned	
Cards	<i>RPS</i>
Trac	<i>ms</i>
Francis	<i>ms</i>
St. Louis	<i>ms</i>
Ind. Map	
...	
...	