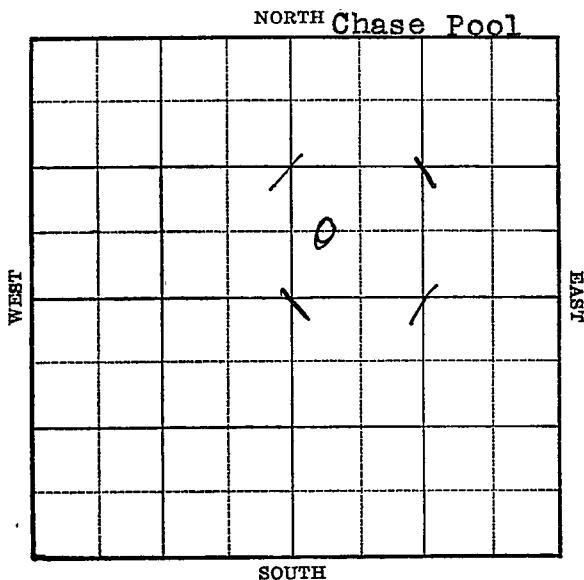


Rice

KANSAS

Section 31 Township 19 Range 9-WWell No. 1 TonnieCompany Gulf

KANSAS


Rice

Sec. 31 Twp. 19 R. 9-WWell No. #1 Tonnie FarmGulf Company

(Chase)

 Ft. from N. Line660 Ft. from S. Line Ft. from E. Line330 Ft. from W. Line

Elev. 1723

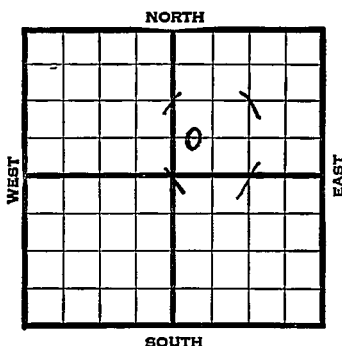

1939	REPORT
5/17	R.R.
	10-3/4" - 240' WOC.
5/26	Dr1g. 2870'
6/1	Arb. 3245' 7" - 3245'
	S.O. 3252' T.D. 3256' RUST.
6/8	3261' T.D. 500 acid.
	131 oil & 98 water.
	3268 T.D. 500' oil, swab 30 bbls
	7 hrs. swab down
6/16	T.D. 3270' 2500 acid.
	Pump 34 oil & 8 water 24 hours.
6/23	T.D. 3276' 46' of 5" liner
	Shut down.
6/29	Pump 30 oil & 40 water 24 hours.
7/6	Shut down.
7/13	Shut down.
7/20	" "
7/27	" "
8/3	" "
8/10	" "
	OVER

1939

8/16

Arb. 3245'

7" - 3245'

T.D. 3276'

4000 acid.

Pump 26 water.

ABANDONED

Map No. 49 Sec. 31 Twp. 19 R. 9WWell No. 1 TonnieGulf

Company

Contractor

FIRST REPORT
C W L SW NE

SECTION PLAT

		X	X
		0	
		X	X

 Ft. from N. Line660 Ft. from S. Line Ft. from E. Line330 Ft. from W. Line

CHASE POOL

Location Rig up

Drilling and Remarks:

RR

10 $\frac{3}{4}$ " @ 240

WOC

RECORD

Cased in., ft.Sand Gas Oil Total Depth

PRODUCTION

1st 24 hrs. Nat. 1st 24 hrs. after shot Gas Cu. Ft.Dry Hole Abandoned

Date

MAY 17 1939 19

S. J. LEWIS Scout

Misc- Small Maps

Cards

Tracing

France Map

Scarborough Map

Moody Map

Geological Dept.

Moody Plat Book

Rice

KANSAS

Map No. 49 Sec. 31 Twp. 19 R. 9WWell No. 1 TommieGulf

Company

Contractor

ABANDONED
C W L SW NE

SECTION PLAT

		0	

 Ft. from N. Line660 Ft. from S. Line Ft. from E. Line330 Ft. from W. Line

CHASE POOL

Location Rig up Drilling and Remarks: Ar 832457" @ 32454000 acidPump 26 water

RECORD

Cased in., ft.Sand Gas Oil Total Depth 3276

PRODUCTION

1st 24 hrs. Nat. 1st 24 hrs. after shot Gas Cu. Ft.Dry Hole Abandoned

Date

AUG 16 1939 19S. J. LEWIS Scout

Misc Small Maps

Cards

Tracing

France Map

Scarborough Map

Moody Map

Geological Dept.

Moody Flat Book