


Rice

Map No. **KANSAS** Sec. *31* Twp. *19* R. *9W*

Well No. *1 Burden* Farm _____

Gepsey Oil Company _____

NORTH

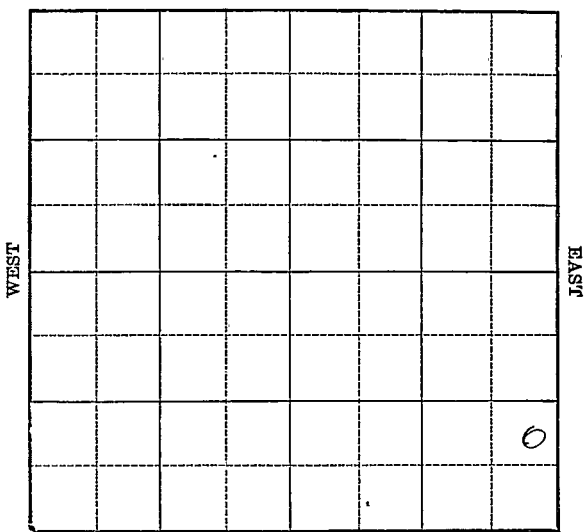

SOUTH

Location _____

Drilling Remarks _____

Rig Up _____

Drilling Remarks _____

RECORD

Cased _____ in. _____ ft.

Sand _____

Gas _____

Oil _____

Total Depth _____

PRODUCTION

1st 24 hrs. Nat. _____

1st 24 hrs. after shot _____

Gas _____ cu. ft.

Dry Hole _____

Abandoned _____

Map No. _____ Sec. 31 Twp. 19 R. 9W

Well No. #1 Burden Farm


Gypsy oil Company

_____ Ft. from N. Line

830 Ft. from S. Line

330 Ft. from E. Line

_____ Ft. from W. Line

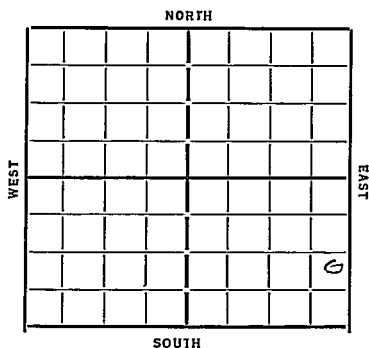

Date 1933

REPORT

7/12 Location

7/19 Bldg Rig

7/26 Spud

8/2 15" 320 dly 1180'

8/9 12" - 1538 " 2070'

8/17 dly 2715'

8/23 Rem 8" 3015'

8/30 Cmg. 3195 Sil L. 3217 T.D. 3227 - 14 ft. oil over time
tanker

9/6 Siliceous 3217 - 3227
Est 1100 bbls

COMPLETED

Map No. 49 Sec. 31 Twp. 19 R. 9W

Well No. #1 - Burden

Gypsy oil Company

Contractor

SECTION PLAT

Ft. from N. Line

830 Ft. from S. Line

330 Ft. from E. Line

Ft. from W. Line

FIRST REPORTS

Location ✓

Rig up

Drilling and Remarks:

RECORD

Cased in., ft.

Sand

Gas

Oil

Total Depth

PRODUCTION

1st 24 hrs. Nat.

1st 24 hrs. after shot

Gas Cu. Ft.

Dry Hole

Abandoned

Date

7/12/33 192 Orval Mannschreck Scout

Map No. 49 Sec. 31 Twp. 19 R. 9WWell No. 1-BurdenGypsy oil Company

Contractor

SECTION PLAT

Ft. from N. Line

830 Ft. from S. Line330 Ft. from E. Line

Ft. from W. Line

COMPLETED

			0

Location

Rig up

Drilling and Remarks:

Est 1100 lbs

RECORD

Cased in, ft.

Sand Shinarump 3277

Gas

Oil

Total Depth 3277

PRODUCTION

1st 24 hrs. Nat.

1st 24 hrs. after shot

Gas Cu. Ft.

Dry Hole

Abandoned

Date

9/6/33 P. Mannschreck (Seal)