

Map No. _____ Sec. 31 Twp. 19 R. 9W

Well No. 1-Cemetery Farm


Robinson-Hensler Company

_____ Ft. from N. Line

313 Ft. from S. Line

313 Ft. from E. Line

_____ Ft. from W. Line

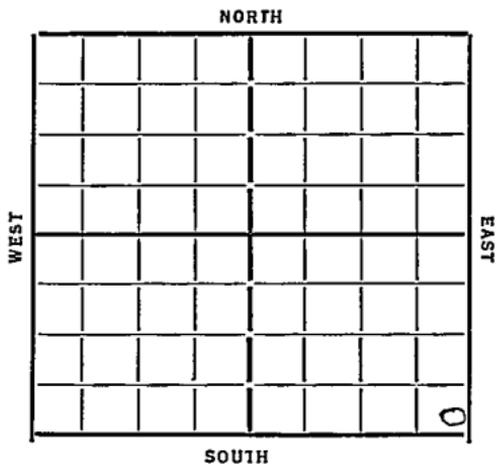

Date
1933

REPORT

7/12 R.g
7/19 dily 550'
7/26 12" - 1030 dily 1780'
8/2 10" 2220' dily 2380'
8/9 dily 2060'
8/17 6" 3219 Top siliceous 3212 Top 3222 east 800th
 per day with acidize
8/23 Siliceous 3212 - 3222 T.D
 1000 gal acid pump 800th

COMPLETED

Map No. _____ Sec. 31 Twp. 19 R. 9W

Well No. 49 1- Cemetery

Robinson & Hinkle Company

Contractor

SECTION PLAT

_____ Ft. from N. Line

31.3 Ft. from S. Line

31.3 Ft. from E. Line

_____ Ft. from W. Line

FIRST REPORTS

RECORD

Location _____

Cased _____ in., _____ ft.

Rig up _____

Sand _____

Drilling and Remarks:

Gas _____

Rig

Oil _____

Total Depth _____

PRODUCTION

1st 24 hrs. Nat. _____

1st 24 hrs. after shot _____

Gas _____ Cu. Ft.

Dry Hole _____

Abandoned _____

Date

7/12/33 192 Oval Manschreck Scout

Map No. 49 Sec. 31 Twp. 19 R. 9W

Well No. 1-Cemetery

Robinson & Henkle Company

Contractor

COMPLETED

SECTION PLAT

			0

Ft. from N. Line

313 Ft. from S. Line

313 Ft. from E. Line

Ft. from W. Line

Location

Rig up

Drilling and Remarks:

1000 gal acid

Pump 500 lbs

RECORD

Cased _____ in., _____ ft.

Sand Delicious 3212

Gas _____

Oil _____

Total Depth 3222

PRODUCTION

1st 24 hrs. Nat. _____

1st 24 hrs. after shot _____

Gas _____ Cu. Ft.

Dry Hole _____

Abandoned _____

Date

8/23/33 O. Mansbach