


Rice

Form 51-5M-11-31-Palace

Map No. KANSAS Sec. 31 Twp. 19 R. 9W
Well No. 1 Christopher Farm
C B Davis Company

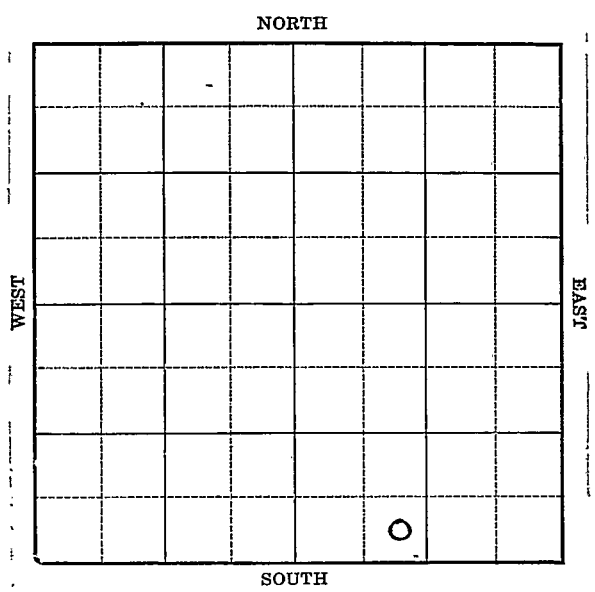

Location _____
Drilling Remarks _____

Rig Up _____
Drilling Remarks _____

RECORD

Cased _____ in. _____ ft.
Sand _____
Gas _____
Oil _____
Total Depth _____

PRODUCTION

1st 24 hrs. Nat. _____
1st 24 hrs. after shot _____
Gas _____ cu. ft. _____
Dry Hole _____
Abandoned _____

Rice

Map No. KANSAS Sec. 31 Twp 19 R. 9W


Well No. 1 Christopher Farm
C B Davis Company

 Ft. from N. Line

330 Ft. from S. Line

 Ft. from E. Line

990 Ft. from W. Line

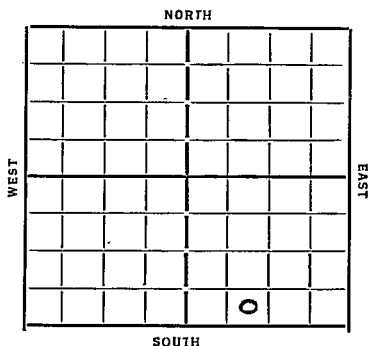

Date
1934

REPORT

<u>2/14</u>	<u>Location</u>		
<u>2/23</u>	<u>Bldg. Rig</u>		
<u>3/1</u>	<u>Rig</u>		
<u>3/8</u>	<u>R 72</u>		
<u>3/15</u>	<u>Drly 330</u>		
<u>3/22</u>	<u>Drly 1200</u>	<u>20" 208</u>	<u>12" 1190</u>
<u>3/29</u>	<u>" 2008</u>	<u>10" at 1851</u>	
<u>4/5</u>	<u>" 2680</u>	<u>8" at 2457</u>	
<u>4/12</u>	<u>" 3090</u>		
<u>4/19</u>	<u>Siliceous 3236 TD 3248</u>		
	<u>1000' oil 1 hr. 2500' 6 hr</u>		
	<u>Tubing</u>		
<u>4/25</u>	<u>Siliceous 3236 TD 3248</u>		
	<u>678 Bbls</u>		

COMPLETED

Map No. 49 Sec. 31 Twp. 19 R. 9WWell No. 1- ChristopherC. B. Davis Company

Contractor

FIRST REPORT

SECTION PLAT

Ft. from N. Line

330 Ft. from S. Line

Ft. from E. Line

990 Ft. from W. LineLocation LocationRig up RDS7

Drilling and Remarks:

RECORD

Cased.....in., ...ft.

Sand.....

Gas.....

Oil.....

Total Depth.....

PRODUCTION

1st 24 hrs. Nat.....

1st 24 hrs. after shot.....

Gas.....Cu. Ft.

Dry Hole.....

Abandoned.....

Date

2-14-34 192 C. Marmesbach Scout

KANSAS

Map No. 49 Sec. 31 Twp. 19 R. 9WWell No. 1-ChristopherC. B. Davis et al Company

Contractor

SECTION PLAT

COMPLETED

Ft. from N. Line

330 Ft. from S. Line

Ft. from E. Line

990 Ft. from W. Line

			0

Location _____

Rig up _____

Drilling and Remarks:

678 bbls

RECORD

Cased _____ in., _____ ft.

Sand Illinois 3236

Gas _____

Oil _____

Total Depth 3248

PRODUCTION

1st 24 hrs. Nat. _____

1st 24 hrs. after shot _____

Gas _____ Cu. Ft.

Dry Hole _____

Abandoned _____

Date

4-25-34 19

ORVAL MANNSCHRECK

Scout