


Section 31 Township 19 Range 9-W

Well No. #1 Coffman

Company Alpine Oil & Royalty

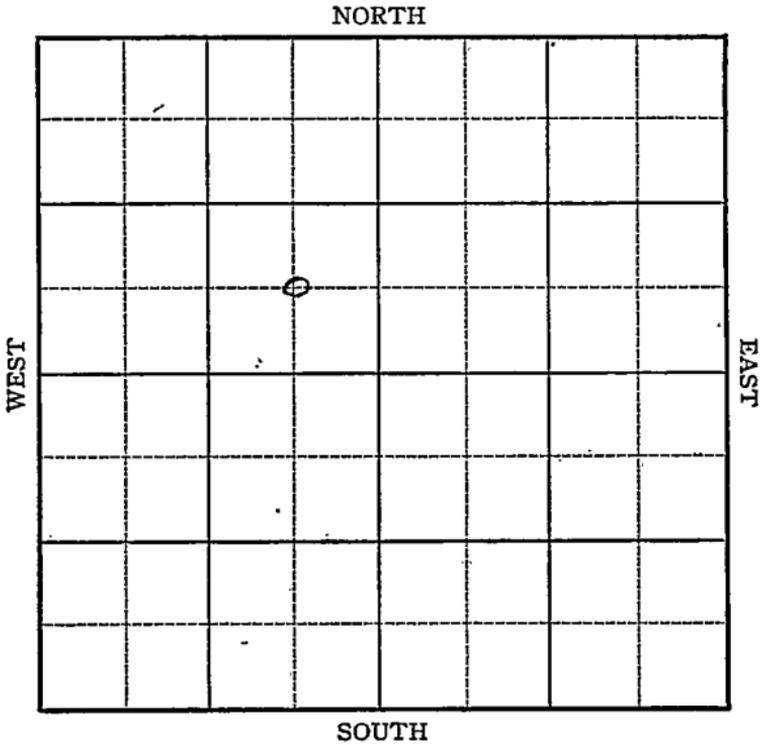

**KANSAS**

Rice

Sec. 31 Twp. 19 R. 9-W

Well No. #1 Coffman Farm  
Alpine Oil & Royalty Company

Chase


         Ft. from N. Line

660 Ft. from S. Line

660 Ft. from E. Line

         Ft. from W. Line

*elev. 1731*

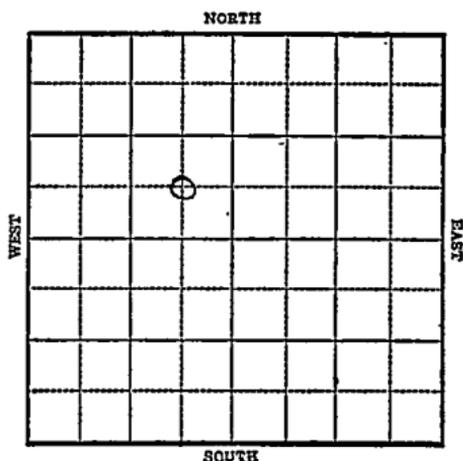

1943

R E P O R T

- 4/7 Rotary
- 4/14 8" @ 205'  
Anhy 365'
- 4/21 Drlg. 2225'  
Lans 2937  
Drlg. 3109'
- 4/28 Drlg. 3278'
- 5/5 Congl 3252  
Rework Arb. 3303  
T.D. 3305'  
No shows.

**ABANDONED**

Rice

Map No. 49 Sec. 31 Twp. 19 R. 9W

KANSAS

Well No. 1 Coffman

Alpine Oil & Royalty Company

**FIRST REPORT**

Contractor

C S E NW

**SECTION PLAT**

\_\_\_\_\_ Ft. from N. Line

660 Ft. from S. Line

660 Ft. from E. Line

\_\_\_\_\_ Ft. from W. Line

	o		

**CHASE POOL**

Location \_\_\_\_\_

Rig up \_\_\_\_\_

Drilling and Remarks:

Rotary

**RECORD**

Cased \_\_\_\_\_ in., \_\_\_\_\_ ft.

Sand \_\_\_\_\_

Gas \_\_\_\_\_

Oil \_\_\_\_\_

Total Depth \_\_\_\_\_

**PRODUCTION**

1st 24 hrs. Nat. \_\_\_\_\_

1st 24 hrs. after shot \_\_\_\_\_

Gas \_\_\_\_\_ Cu. Ft.

Dry Hole \_\_\_\_\_

Abandoned \_\_\_\_\_

Date

APR 7 1943 19

S. I. LEWIS Scout

Rice

KANSAS

Map No. 49 Sec. 31 Twp. 19 R. 9WWell No. 1 Coffman

Alpine Oil &amp; Royalty Company

ABANDONED

Contractor

C S E NW

SECTION PLAT


\_\_\_\_\_ Ft. from N. Line

660 Ft. from S. Line660 Ft. from E. Line

\_\_\_\_\_ Ft. from W. Line

CHASE POOL

Location \_\_\_\_\_

Rig up \_\_\_\_\_

Drilling and Remarks:

*Congl 3252*  
*Re work Oct 3303*  
*No show*

RECORD

Cased \_\_\_\_\_ in., \_\_\_\_\_ ft.

Sand \_\_\_\_\_

Gas \_\_\_\_\_

Oil \_\_\_\_\_

Total Depth 3305

PRODUCTION

1st 24 hrs. Nat. \_\_\_\_\_

1st 24 hrs. after shot \_\_\_\_\_

Gas \_\_\_\_\_ Cu. Ft.

Dry Hole \_\_\_\_\_

Abandoned \_\_\_\_\_

Date

MAY 5 1943 19

S. J. LEWIS Scout