

Rice


Form 51-5M-11-31-Palace

Map No. **KANSAS** Sec. *31* Twp. *19* R. *9^W*

Well No. *4 Community* Farm

Ramsay et al Company

NORTH *St Bbb-3 & 4*

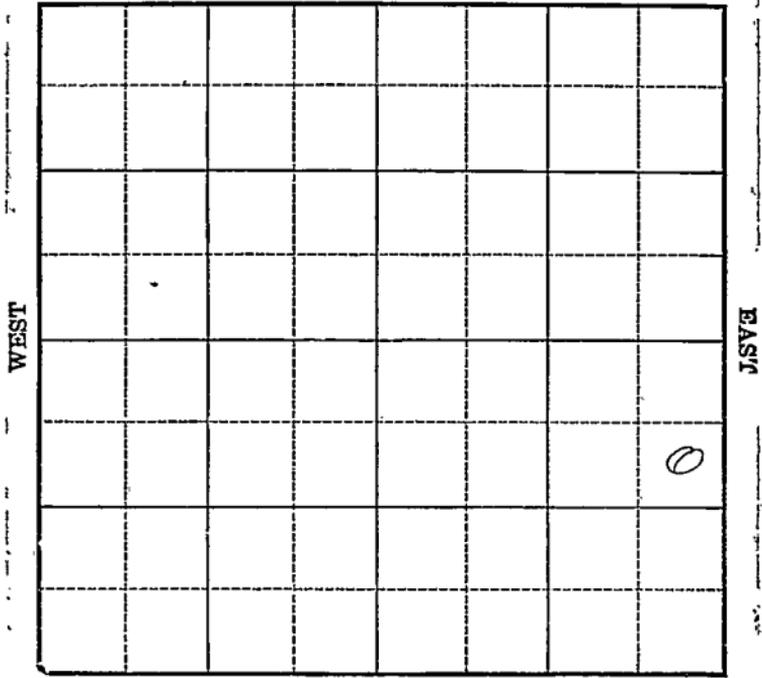

Location _____

Drilling Remarks _____

Rig Up _____

Drilling Remarks _____

RECORD

Cased _____ in. _____ ft.

Sand _____

Gas _____

Oil _____

Total Depth _____

PRODUCTION

1st 24 hrs. Nat. _____

1st 24 hrs. after shot _____

Gas _____ cu. ft.

Dry Hole _____

Abandoned _____

Rice

KANSAS

Form 252-A
5M 4-32 MPC

Map No. _____ Sec. 31 Twp 19 R. 9W


Well No. 4 - Community Farm
Ramsey et al Company

825 Ft. from N. Line

_____ Ft. from S. Line

500 Ft. from E. Line

_____ Ft. from W. Line

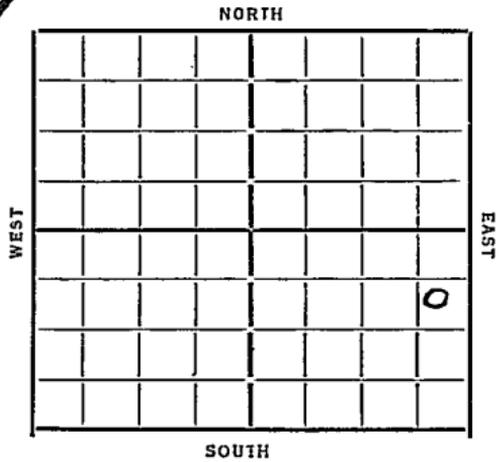

Date 1933

REPORT

8/16 Reg'in up

8/23 _____

8/30 spud

9/6 20" at 218 - 15" at 430 - 12" at 1172

9/13 diag 1955

9/20 12 1/2" 1172 - 10" - 1925' log 2560'

9/29 diag 2760

10/5 " 2050'

10/11 top sil line 3226 - 1600' oil

10/18 swab 418 bbls in 4 hrs

10/25 lump 85 bbls per hr.

11/1 Silencer 3226 J.D. 3236
pump for 1392 bbls
COMPLETED

Map No. 49 Sec. 31 Twp. 19 R. 9W

Well No. #4 Community

Barnes et al Company

Contractor

SE Block 34

SECTION PLAT

825 Ft. from N. Line

..... Ft. from S. Line

500 Ft. from E. Line

..... Ft. from W. Line

			●

FIRST REPORTS

Location.....

Rig up.....

Drilling and Remarks:

Rig up

RECORD

Cased..... in., ft.

Sand.....

Gas.....

Oil.....

Total Depth.....

PRODUCTION

1st 24 hrs: Nat.....

1st 24 hrs: after shot.....

Gas..... Cu. Ft.

Dry Hole.....

Abandoned.....

Date

8/6/33 192 Orval Mann Scout

Map No. 49 Sec. 31 Twp. 19 R. 9W

Well No. H-Community

Ramsey et al Company

Contractor

SECTION PLAT

825 Ft. from N. Line

..... Ft. from S. Line

500 Ft. from E. Line

..... Ft. from W. Line

COMPLETED

			o

Location.....

Rig up.....

Drilling and Remarks:

RECORD

Cased.....in.,ft.

Sand silicious 3226

Gas.....

Oil.....

Total Depth 3236

PRODUCTION

1st 24 hrs. Nat.....

1st 24 hrs. after shot.....

Gas.....Cu. Ft.

Dry Hole.....

Abandoned.....

Date

11-1-33 192

O. Mammes Seal