

Rece

Map No. KANSAS Sec. 31 Twp 19 R. 9W


Well No. 1-Kennedy Farm
Gypsy Company

_____ Ft. from N. Line

330 Ft. from S. Line

1006 Ft. from E. Line

_____ Ft. from W. Line

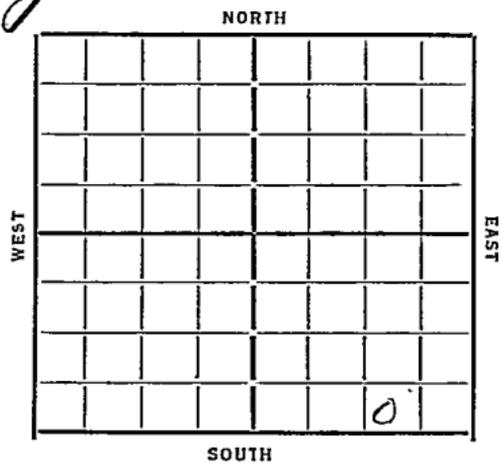

Date
1933

REPORT

8/30 moving in
9/6 Rigging up
9/13 20" at 187- 15" at 310 - TAD 720
9/20 dily ~~213~~ 1675 - 12" - 1150'
9/29 fishing at 2700
10/5 10" 2207 W.P. 10" 2246'
10/11 nleg 3005
10/18 Simpson 3247 - set 6"
Top sil 3250 - T.D. 3256 -
800' oil in 40 minutes
10/25 Silicious 3250
T.D. 3256
428 bbls 12 hours

COMPLETED

Map No. 49 Sec. 31 Twp. 19 R. 9W

Well No. 1-Kennedy

Gypsy Company
Contractor

FIRST REPORTS

..... Ft. from N. Line

330 Ft. from S. Line

1006 Ft. from E. Line

..... Ft. from W. Line

SECTION PLAT

Location.....

Rig up.....

Drilling and Remarks:

Moving in

RECORD

Cased.....in.,ft.

Sand.....

Gas.....

Oil.....

Total Depth.....

PRODUCTION

1st 24 hrs. Nat.....

1st 24 hrs. after shot.....

Gas.....Cu. Ft.

Dry Hole.....

Abandoned.....

Date

8/30/33 192 O. Manschick Scout

Map No. 49 Sec. 31 Twp. 19 R. 9W

Well No. 1-Kennedy

Gypsy Oil Company

Contractor

SECTION PLAT

..... Ft. from N. Line

330 Ft. from S. Line

1006 Ft. from E. Line

..... Ft. from W. Line

COMPLETED

Location.....

Rig up.....

Drilling and Remarks:

428 bbls
12 hours

RECORD

Cased..... in., ft.

Sand siliceous 3250

Gas.....

Oil.....

Total Depth 3256

PRODUCTION

1st 24 hrs. Nat.....

1st 24 hrs. after shot.....

Gas..... Cu. Ft.

~~Dry Hole~~.....

Abandoned.....

Date

10-25-33 192 O. Munnich Scout