


Rice

Map No. **KANSAS** Sec. *31* Twp. *19* R. *9W*

Well No. *1 Lansing* Farm _____

Ramsey Company _____

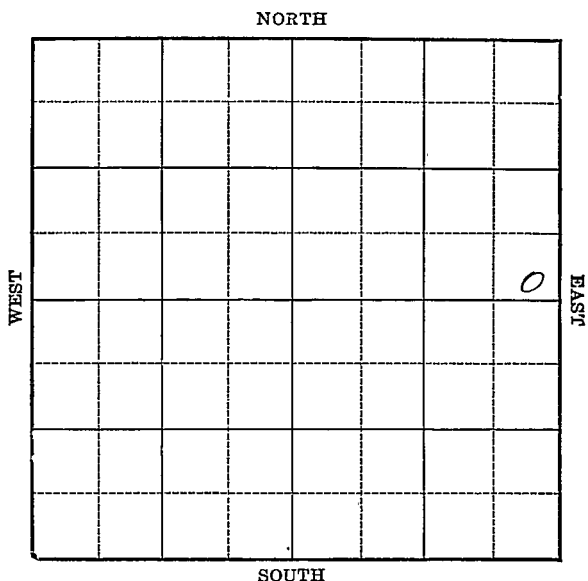

Location _____

Drilling Remarks _____

Rig Up _____

Drilling Remarks _____

RECORD

Cased _____ in. _____ ft.

Sand _____

Gas _____

Oil _____

Total Depth _____

PRODUCTION

1st 24 hrs. Nat. _____

1st 24 hrs. after shot _____

Gas _____ cu. ft.

Dry Hole _____

Abandoned _____

Rice

Map No. KANSAS Sec. 31 Twp. 19 R. 9W


Well No. 1- Lansing Farm
Ramsley Company

 Ft. from N. Line

250 Ft. from S. Line

560 Ft. from E. Line

 Ft. from W. Line

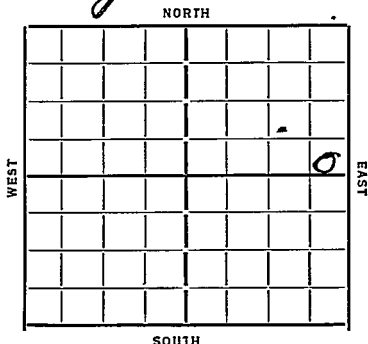

Date 1933

REPORT

9/27 Location
10/13
10/14 20" at 212 - Aereg 330
10/18 15" at 416 " 1080
10/25 Aereg 1675 12" at 1195
11/1 T.D. 2515 - Run 8"
11/8 Top Siliceous 3222 - show oil
11/15 T.D. 3271 - no test
11/22 Swab 11 bbls per hour
11/29 Treated with 1000 gal acid
Swab 39 bbls 13 hrs.
12/6 no test
12/13 Siliceous 3222 T.D. 3271'
645 oil - 105 water
COMPLETED

Map No. 49 Sec. 31 Twp. 19 R. 9W

Well No. 1- Lansing

Ramsey Company

Contractor

SECTION PLAT

Ft. from N. Line

250 Ft. from S. Line

560 Ft. from E. Line

Ft. from W. Line

			0

FIRST REPORTS

Location

Rig up

Drilling and Remarks:

RECORD

Cased in., ft.

Sand

Gas

Oil

Total Depth

PRODUCTION

1st 24 hrs. Nat.

1st 24 hrs. after shot

Gas Cu. Ft.

Dry Hole

Abandoned

Date
SEP 27 1933

192

O. Mannheim Scout

Map No. 49 Sec. 31 Twp. 19 R. 9WWell No. 1-LansingBarnsey Company

Contractor

COMPLETED

Ft. from N. Line

250 Ft. from ~~S.~~ Line560 Ft. from E. Line

Ft. from W. Line

SECTION PLAT

			0

Location

Rig up

Drilling and Remarks:

645 oil
105 water

RECORD

Cased in., ft.

Sand blueous 3222

Gas

Oil

Total Depth 3271

PRODUCTION

1st 24 hrs. Nat.

1st 24 hrs. after shot

Gas Cu. Ft.

Dry Hole

Abandoned

Date

12-11-33 192O. W. Mammick Scout