

Rice


Form 51-5M-11-31-Palace

Map No. \_\_\_\_\_ Sec. 31 Twp. 19 R. 9W

Well No. 1 - Linville \_\_\_\_\_ Farm

Ramsey \_\_\_\_\_ Company

NORTH

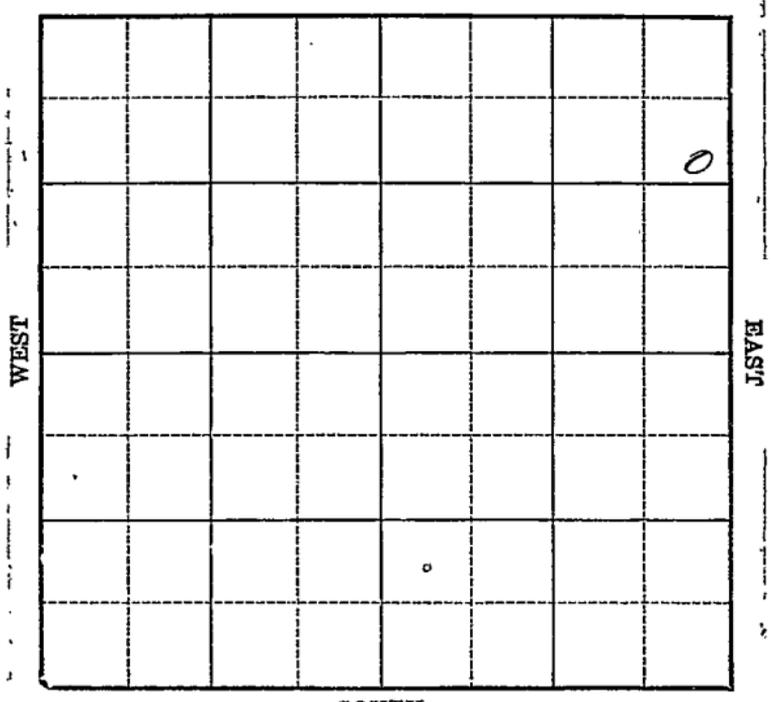

Location \_\_\_\_\_

Drilling Remarks \_\_\_\_\_

\_\_\_\_\_

\_\_\_\_\_

Rig Up \_\_\_\_\_

Drilling Remarks \_\_\_\_\_

\_\_\_\_\_

\_\_\_\_\_

RECORD

Cased \_\_\_\_\_ in. \_\_\_\_\_ ft.

Sand \_\_\_\_\_

Gas \_\_\_\_\_

Oil \_\_\_\_\_

Total Depth \_\_\_\_\_

PRODUCTION

1st 24 hrs. Nat. \_\_\_\_\_

1st 24 hrs. after shot \_\_\_\_\_

Gas \_\_\_\_\_ cu. ft.

Dry Hole \_\_\_\_\_

Abandoned \_\_\_\_\_

Map No. \_\_\_\_\_ Sec. 31 Twp. 19 R. 9W

Well No: 1-Lenville Farm \_\_\_\_\_


Ramsey Company \_\_\_\_\_

960 Ft. from N. Line

\_\_\_\_\_ Ft. from S. Line

180 Ft. from E. Line

\_\_\_\_\_ Ft. from W. Line

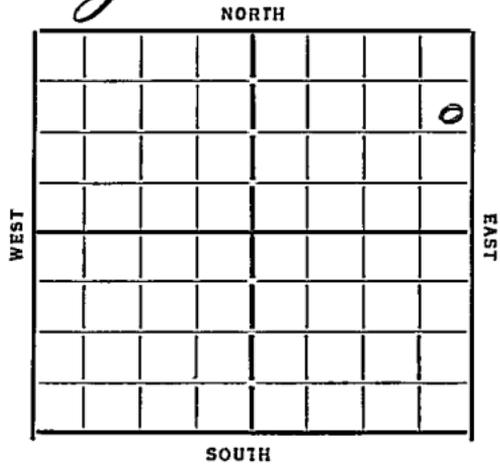

Date  
1933

REPORT

7/19 Spud

7/26 20" 210 -15" -136' dely 530'

8/2 12"-1191 h dely 1391

8/9 16" 1863 " 1975'

8/16 dely 2640 - 8" 2235'

8/23 show oil 2960-65 @ 0.2978'

8/30 Siliceous 3240 T.D. 3272 1/2 2000' oil

9/6 no test yet

9/13 \_\_\_\_\_

9/20 Siliceous 3240  
T.D. 3272 1/2  
pump 215 bbls  
22 hours

COMPLETED

KANSAS

Map No. Rice 49 Sec. 31 Twp. 19 R. 9WWell No. #1 LinnelleRamsay Company

Contractor

## SECTION PLAT


960 Ft. from N. Line

..... Ft. from S. Line

180 Ft. from E. Line

..... Ft. from W. Line

## FIRST REPORTS

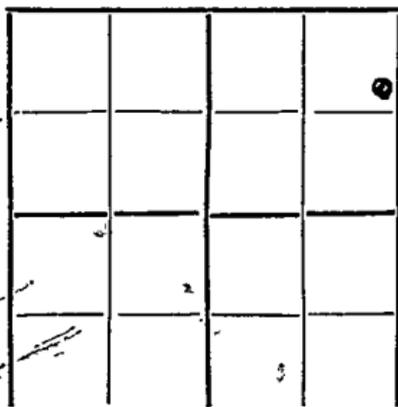

Location.....

Rig up.....

Drilling and Remarks:

spud

## RECORD

Cased..... in., ..... ft.

Sand.....

Gas.....

Oil.....

Total Depth.....

## PRODUCTION

1st 24 hrs. Nat.....

1st 24 hrs. after shot.....

Gas..... Cu. Ft.

Dry Hole.....

Abandoned.....

Date

7/19/33 192 Oval Manschuck Scout

Map No. 49 Sec. 31 Twp. 19 R. 9W

Well No. 1- Linnell

Ramsey Company

Contractor

## SECTION PLAT

960 Ft. from N. Line

..... Ft. from S. Line

180 Ft. from E. Line

..... Ft. from W. Line

**COMPLETED**

			0
*		"	

Location.....

Rig up.....

Drilling and Remarks:

Pump 215  
bbbs 22 hours

## RECORD

Cased..... in., ..... ft.

Sand silicious 3240

Gas.....

Oil.....

Total Depth 3272 1/2

## PRODUCTION

1st 24 hrs. Nat.....

1st 24 hrs. after shot.....

Gas..... Cu. Ft.

Dry Hole.....

Abandoned.....

Date

9/29/33 192 O. Mannesbach Scout