



Map No. \_\_\_\_\_ Sec. 31 Twp 19 R. 9-W

Well No. 1-Methodist Farm \_\_\_\_\_


Ramsey Company \_\_\_\_\_

\_\_\_\_\_ Ft. from N. Line

115 Ft. from S. Line

112 Ft. from E. Line

\_\_\_\_\_ Ft. from W. Line

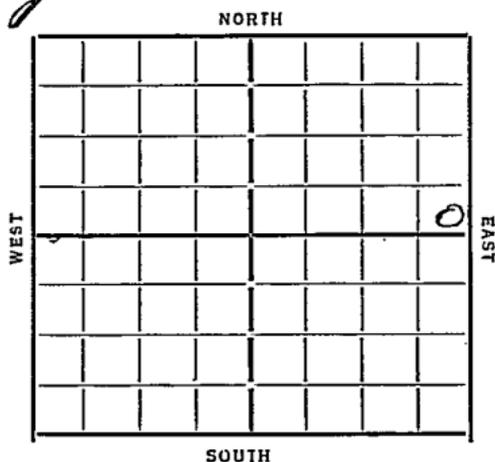

Date 1933

REPORT

8/16 DIG. 1035

8/23 " 1615

8/30 P' 2237 N. 7. W 2200' dly 2495'

9/6 10 reg 3010

9/13 2nd sil 3232 - out at 3238

T. D. 3267 swab 35 bbls per hr

9/22 Siliceous 3232

T. D. 3271 1/2

pump 210 bbls

6 hours

COMPLETED

Map No. 49 Sec. 31 Twp. 19 R. 9W

Well No. 1-Methodist

Ramsey Company

Contractor

SECTION PLAT

..... Ft. from N. Line

115 Ft. from S. Line

112 Ft. from E. Line

..... Ft. from W. Line

			●

FIRST REPORTS

Location.....

Rig up.....

Drilling and Remarks:

RECORD

Cased.....in., .....ft.

Sand.....

Gas.....

Oil.....

Total Depth.....

PRODUCTION

1st 24 hrs. Nat. ....

1st 24 hrs. after shot.....

Gas.....Cu. Ft.

Dry Hole.....

Abandoned.....

Date

8/16/33 192 C. Manschreck Scout

Map No. 49 Sec. 31 Twp. 19 R. 9W

Well No. 1-Methodist Church

Ramsey Company

Contractor

SECTION PLAT

Ft. from N. Line

115 Ft. from S. Line

112 Ft. from E. Line

Ft. from W. Line

			0

**COMPLETED**

Location

Rig up

Drilling and Remarks:

Pump 210  
bbls 6 hours

RECORD

Cased \_\_\_\_\_ in., \_\_\_\_\_ ft.

Sand silicious 3232

Gas \_\_\_\_\_

Oil \_\_\_\_\_

Total Depth 3271 1/2

PRODUCTION

1st 24 hrs. Nat. \_\_\_\_\_

1st 24 hrs. after shot \_\_\_\_\_

Gas \_\_\_\_\_ Cu. Ft.

Dry Hole \_\_\_\_\_

Abandoned \_\_\_\_\_

Date

9/22/33 192 O. Mannschreck Scout