


Section 31 Township 19 Range 13W

Well No. #1 Brining

Company G. M. & R. Drlg.

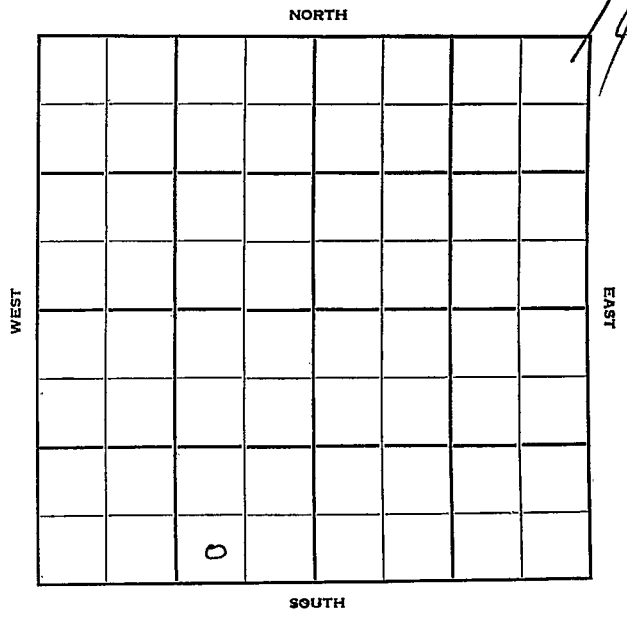

Sec. 31 Twp. 19 R. 13 W

Well No. # 1 Brining Farm

G. M. & R. Drlg. Company

Greeley Contractor
Wildcat


_____ Ft. from N. Line

330 Ft. from S. Line

990 Ft. from E. Line

_____ Ft. from W. Line

SW SE SW

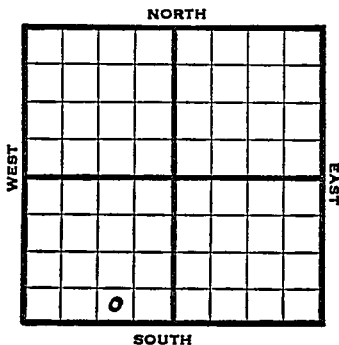

1952 Elev. 1865' REPORT

5/21 Spud 5-18-52'
Drlg. 316'

5/28 Anhy 765'
8" @ 775' Drlg. 2870'

6/11 Spud 5-18-52
D&A TD 3517'
Anhy 765 8" @ 775'
DST 3200-3274 open 3/4 hr.
rec. 110' so & gcm
Heeb. 3087 DST 3322-55 open 1 hr.
rec. 33' mud Cong. 3448 Re Arb. 3474
Arb. 3477 TD 3498
DST 3479-98 open 1/2 hr. rec. 40' gcm
TD 3517 D&A

ABANDONED

