


Section 31 Township 19 Range 13W

Well No. 1 Schridde

Company Poindexter Bros. Well Servicing Co.

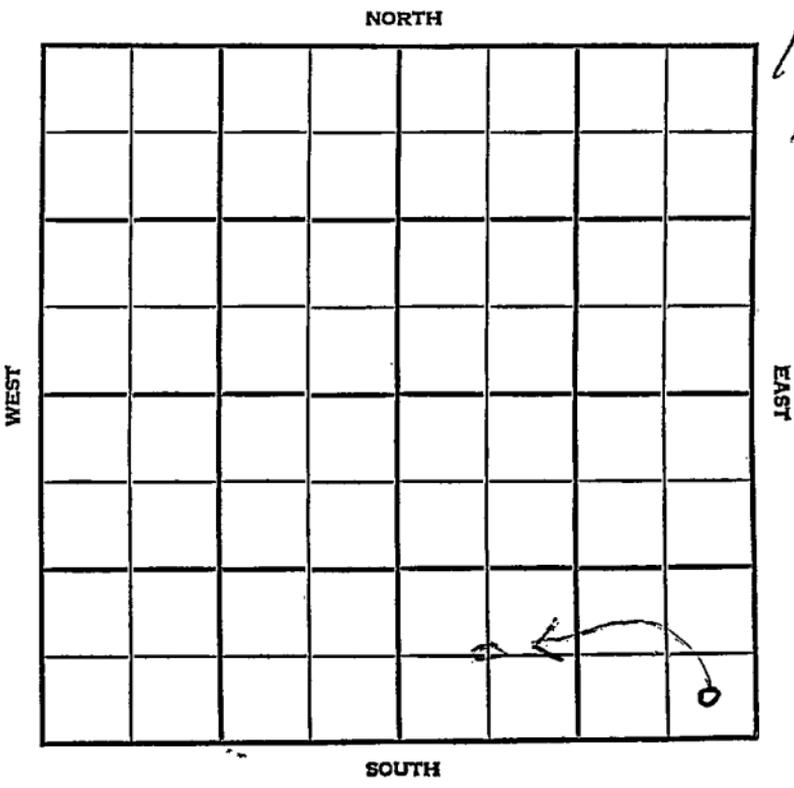

Barton

MINNAPAS


SEC.	TWP.	R.
31	19	13W

WELL NO. #1 Schridde FARM

COMPANY Poindexter Bros. Well Servicing Co.

CONTRACTOR Jackson

Wildcat
 _____ Ft. from N. Line
~~330~~ 660 _____ Ft. from S. Line
~~330~~ _____ Ft. from E. Line
 660 _____ Ft. from W. Line
 CSW
~~SE SE SE~~

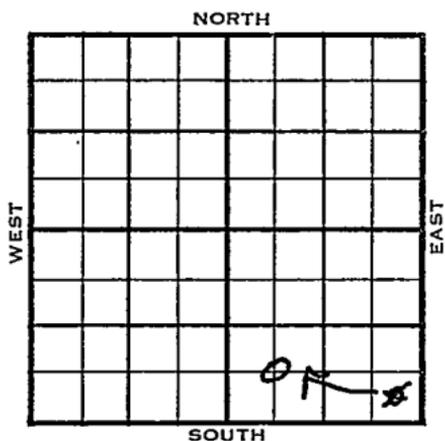

	ELEVATION	REPORT
1955	1861'	
3/2	Arb. 3462'	
	TD 3735'	
3/9	D & A	
	TD 3735'	
	8" @ 765'	
	Heeb. 3075', Tor. 3089' B. Oread. 3108'	
	Br. Lime. 3176', Lans 3188' Congl.	
	3433' Arb. 3462'	
	DST 3191'-3212' opn 1hr, rec 35' vso & gcm 200#	
	DST 3463'-95' opn 1 hr, gas in 20 min rec 40' Mud, 510#	
	TD 3735'	
	D & A	

ABANDONED

County Barton State Kansas
 Sec. 31 (Blk. 19 (Sur. 13W Map No. 19)
 Operator Poindexter Bros. Well Servicing Co.
 Well No. 1 Farm Schridde
 Elev. _____ Location SE SE SE

FIRST REPORT

↖

330 Ft. From S Line SE
330 Ft. From E Line Quarter
 Ist. Report MAR 2 1955
 Completion _____
 Remarks See correction
Jackson - Contr.
 Spudding Date _____

Drig. Data Wildcat
Arb. 3462 TD 3735

FABEN GILSTRAP

SCOUT TICKET

DX-201

Kansas

SEC.	TWP.	R.
31	19	13W

WELL NO.

1 Schridde

FARM

COMPANY

Poindexter Bros. Well Servicing

CONTRACTOR

CORRECTION

C SW SE

NORTH

____ FT. FROM N. LINE


660

____ FT. FROM S. LINE

____ FT. FORM E. LINE

660


____ FT. FROM W. LINE

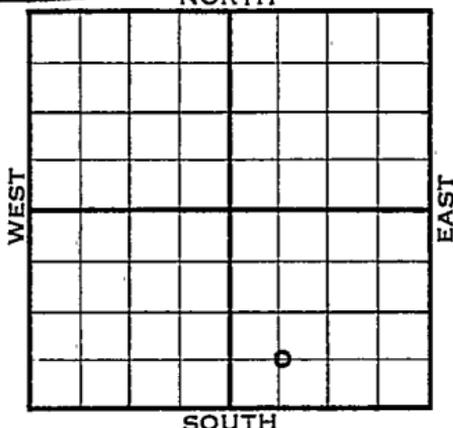

Barton County

<input type="checkbox"/> LOCATION <input type="checkbox"/> RIG UP DRILLING AND REMARKS: <div style="border: 1px solid black; border-radius: 50%; padding: 5px; display: inline-block;"> Reported SE SE SE </div>	RECORD	CASED _____ IN., _____ FT.
		SAND _____
	PRODUCTION	GAS _____
		OIL _____
		TOTAL DEPTH _____
		1ST 24 HRS. NAT. _____
		1ST 24 HRS. AFTER SHOT _____
		GAS _____ CU. FT.
		DRY HOLE _____
		ABANDONED _____
DATE	SCOUT	
MAR 9 1955		TABEN GILSTRAP

County Barton State Kan.
 Sec. 31 (Blk. 19 (Sur. 13W Map No. 13W)
 Operator Poindexter Bros. Well Servicing Co.
 Well No. 1 Farm Schridde
 Elev. 1861 Location C SW SE

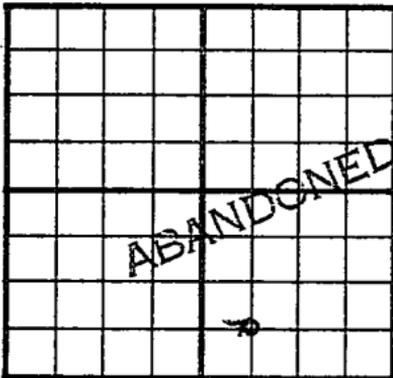

660 Ft. From S Line SE Quarter
660 Ft. From W Line
 1st. Report _____
 Completion MAR 9 1955
 Remarks Wildcat
Jackson - Contr.
 Spudding Date _____

Drilg. Data D & A TD 3735
8" @ 765 Heeb. 3075 Tor. 3089
B. Oread 3108 Br. lime 3176 Lens. 3188
Congl. 3433 Arb. 3462 DST 3191-3212
open 1 hr. Rec. 35' vso & gcm 200#
DST 3463-95 open 1 hr. gas in 20 min.
Rec. 40' mud 510# TD 3735
D & A

FABEN GILSTRAP