


KANSAS Barton County

FORM 51 5M PETROL

Section 31 Township 19 Range 12W

Well No. 1 Harris

Company W. H. Hartman

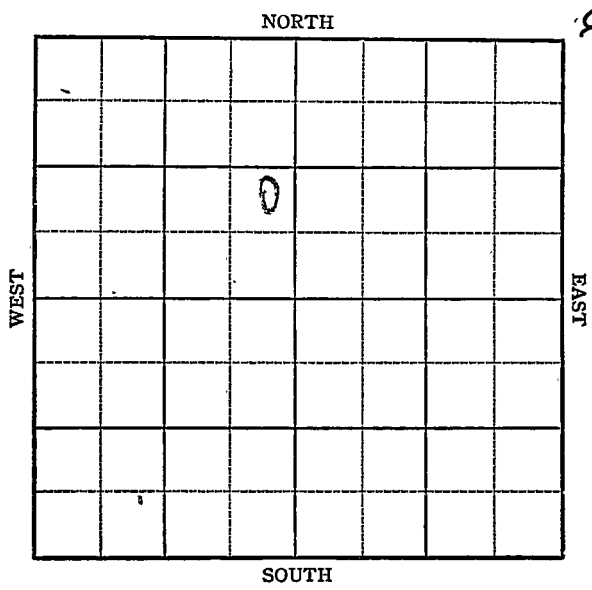


Sec. 31 Twp. 19 R. 12W

Well No. 1 Harris Farm
W. H. Hartman Company

Wildcat

_____ Ft. from N. Line
990 Ft. from S. Line
330 Ft. from E. Line
_____ Ft. from W. Line

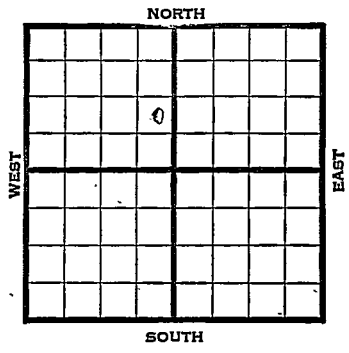

NE SE NW

1945 Elev. 1827 REPORT

6/6 8" -298
WOC
6/14 Anhy 640
Drlg. 2696
6/21 Lams 3154
Arb 3396-3404 TD
SO
5" @ 3396 RUST
6/28 6 qts 150' oil 8 hrs
1500 acid
7/3 71 shots 3393-3405 $\frac{1}{2}$
TD 3430 2 WPH PB
7/11 PB 3409
500 acid.
500' oil plus 150' W. in 12 hrs.
7/19 2000 acid.
20 qts. 3396-3404 CO
7/23 Arb. 3396
5" @ 3396
TD 3430

ABANDONED

Kansas Pool Name Wildcat

Map No. 46 Sec. 31 Twp. 19 R. 12W

Well No. 1 Harris

W. H. Hartman Company

FIRST REPORT Contractor

NE SE NW

SECTION PLAT

	o		

_____ Ft. from N. Line

990 Ft. from S. Line

330 Ft. from E. Line

_____ Ft. from W. Line

Barton County

Location _____

Rig up _____

Drilling and Remarks:

8" -298 WOC

RECORD

Cased _____ in., _____ ft.

Sand _____

Gas _____

Oil _____

Total Depth _____

PRODUCTION

1st 24 hrs. Nat. _____

1st 24 hrs. after shot _____

Gas _____ Cu. Ft.

Dry Hole _____

Abandoned _____

Date

JUN 6 1945 19

S. I. LEWIS Scout

