


KANSAS

Section 31 Township 19 Range 12W

Well No. #10 Kohler

Company W. L. Hartman

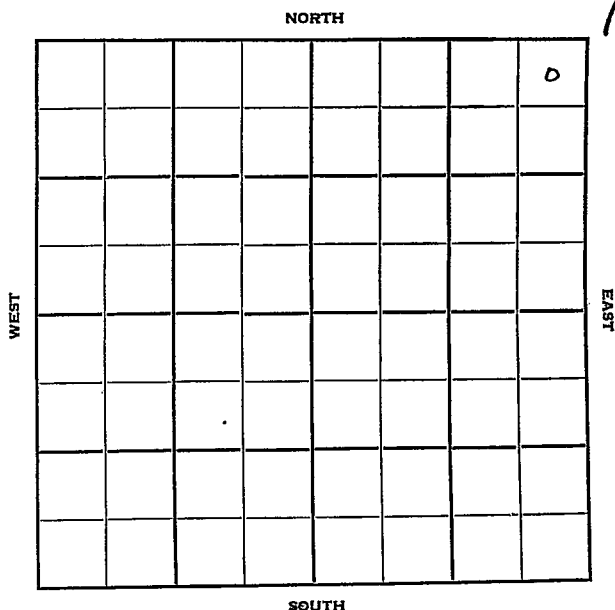

KANSAS

Barton

Sec. 31 Twp. 19 R. 12W

Well No. #10 Kohler Farm

W. L. Hartman Company

Contractor

Ft. Zarah Pool

NORTH


330' Ft. from N. Line

Ft. from S. Line

330' Ft. from E. Line

Ft. from W. Line

NE NE NE

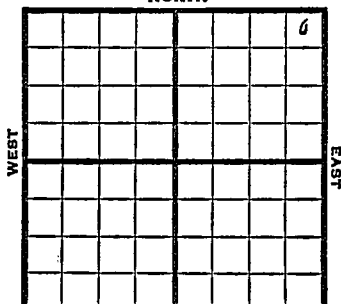

SOUTH

1951

Elev. 1820

REPORT

11/21

Spud 11-18-51

8" @ 192

WOC

1952

1/23

Spud 11-18-51

Oil Well TD 3376

8" @ 192

DST 2922-33 opn $\frac{1}{2}$ hr

Rec. 650' gas 30' gcm

Heeb. 2976 Br lime 3092

Lans. 3107

DST 3107-20 opn 20 min.

Rec. 20' gcm 517,000 gas

DST 3118-36 opn $\frac{1}{2}$ hr.

Rec. 60' o& gcm

30' gcm Cong. 3350 Arb. 3370-72

5" @ 3370 TD 3376 Comp. 281 bopd

COMPLETED

County Barton State Kansas

Sec. 31 (Blk. Twp.) 19 (Sur. Rge.) 12W Map No.

Operator W. L. Hartman

Well No. 10 Farm Kohler

Elev.	Location	NE NE NE
-------	----------	----------

0

FIRST REPORT

330 Ft. From N Line NE

330 Ft. From  Line Quarter

Ist. Report NOV 21 1951

Completion

Remarks

Spudding Date **11-18-51**

Drig. Data Ft. Zarah Pool

8th @ 192 WOC

J. E. TYRA

County Barton State Kansas
 Sec. 31 (Blk. 19) (Sur. 12W) Map No. 12W
 Operator W. L. Hartman
 Well No. 10 Farm Kohler
 Elev. 1820 Location NE NE NE

						0

330 Ft. From N Line NE
330 Ft. From E Line Quarter
 Ist. Report
 Completion JAN 23 1952
 Remarks Ft. Zarah Pool
 Spudding Date 11-18-51

Drlg. Data Oil well TD 3376
8" @ 192 DST 2922-33 open $\frac{1}{2}$ hr.
Rec. 650' gas 30' gcm Heeb. 2976
Br. lime 3092 Lans. 3107 DST 3107-20
open 20 min. Rec. 20' gcm 517,000 gas
DST 3118-36 open $\frac{1}{2}$ hr. Rec. 60' o & gcm
30' gcm Cong. 3350 Arb. 3370-72
5" @ 3370 TD 3376 Comp. 281 bopd

J. G. McGEHEE