KANSAS

FORM 51 5M 11-44 PETROL

Ness County

Section 31 Township 19 Range 25W

Well No. #3 Bowman

Company Chalmette Pet.

7

NORTH

WEST

EAST

SOUTH

FORM 252-A
5M 8-45 PETROL

KANSAS Ness County

Sec. 31 Twp. 19 R. 25-W

Well No. #3 Bowman Farm

Chalmette Pet. Company

Manento

Ft. from N. Line

990 Ft. from S. Line

Ft. from E. Line

330 Ft. from W. Line

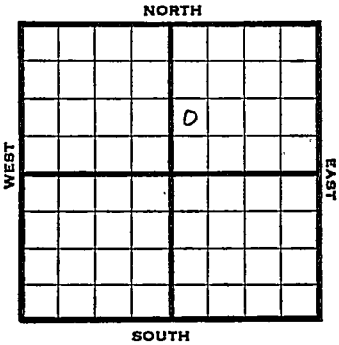

NW SW NE

1946	2564 REPORT
6/19	Location
6/26	"
7/3	"
7/9	RUR
7/16	13" @ 349 Drlg 3295'
7/23	Drlg 4281'
7/30	Anhy 1805 Lans 3930 Miss 4552 TD 4556 5" @ 4553, RUST
8/6	TD 4562 500 acid swb 20 oil PH
8/13	" " "
8/20	" " "
8/27	" " "
9/5	Miss 4552' 5" @ 4553' 500 Acid TD 4562' Pump 120 Pot 37.5 Grav

COMPLETED

FORM 26 200 BKS. 2-44 PETROL

KANSAS

Kansas Pool Name Manento

Map No. 78 Sec. 31 Twp. 19 R. 25W

Well No. 3 Bowman

Chlamette Pet. Company

FIRST REPORT Contractor

NW SW NE

SECTION PLAT

		o	

Ft. from N. Line

990 Ft. from S. Line

Ft. from E. Line

330 Ft. from W. Line

Ness County

Location x

Rig up

Drilling and Remarks:

RECORD

Cased in., ft.

Sand

Gas

Oil

Total Depth

PRODUCTION

1st 24 hrs. Nat.

1st 24 hrs. after shot

Gas Cu. Ft.

Dry Hole

Abandoned

Date

JUN 19 1946 19 S. J. LEWIS Scout

FORM 56 200 BKS. 1-44 PETROL

Kansas

Pool Name Manento

Map No. 78 Sec. 31 Twp. 19 R. 25W

Well No. 3 Bowman

Chalmette Pet. Company

COMPLETED Contractor

NW SW NE

E1.2564

SECTION PLAT

		a	

Ft. from N. Line

990 Ft. from S. Line

Ft. from E. Line

330 Ft. from W. Line

Ness County

Location

Rig up

Drilling and Remarks:

Miss 4552

5" @ 4553

500 Acid

Pump 120 Bd.

375 Gr

RECORD

Cased in., ft.

Sand

Gas

Oil

Total Depth 4563

PRODUCTION

1st 24 hrs. Nat.

1st 24 hrs. after shot

Gas Cu. Ft.

Dry Hole

Abandoned

Date

SEP 5 1946 19

S. J. LEWIS Scout