


Section 31 - Township 19 Range 25W

Well No. 1 Gantz

Company Chalmette Oil

3

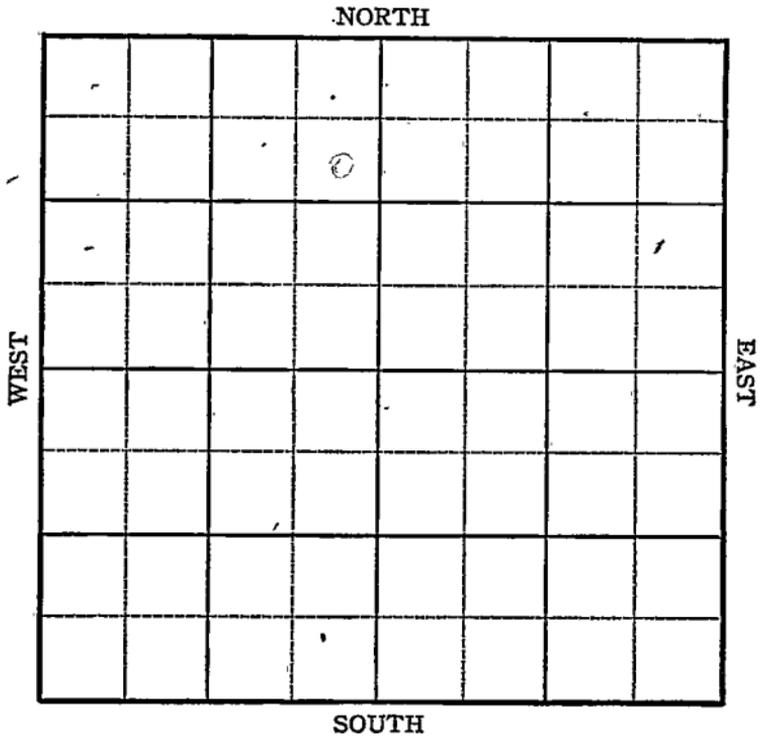

Sec. 31 Twp. 19 R. 25-W

Well No. #1 Gantz Farm

Chalmette Oil Company


990 Ft. from N. Line

_____ Ft. from S. Line

330 Ft. from E. Line

_____ Ft. from W. Line

SE NE NW Elev. 2570

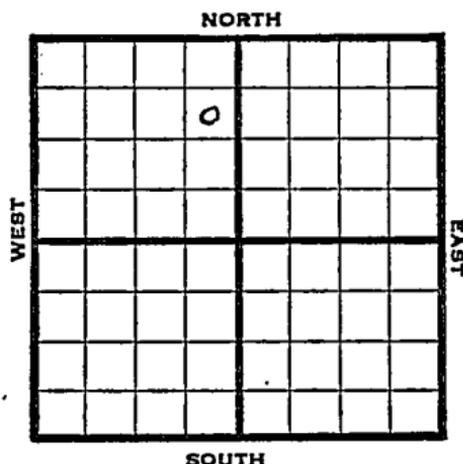

1945

REPORT

9/5	Location
9/12	Surface Hole
9/19	13" @ 205 Drlg. 2673
9/26	Drlg. 3278
10/3	Drlg. 4196
10/10	Lans 3930 Cong 4544 Miss 4558 Drlg. 4563 SO
10/17	TD 4567 5" @ 4560 RUST
10/24	" " "
10/31	500 acid.
11/7	" "
11/14	TD 4585 HFW PB
11/21	PB 4578 15 qts. 4565-4573 500 acid. Swab 3 oil per hr.
11/28	" " " " "
12/5	" " " " "
12/12	M " " " "
12/20	" " " "
12/29	" " " "
1946	
1/10	" " " "
1/17	" " " "
1/24	" " " "
1/31	" " " "

OVER


KANSASPool Name No nameMap No. 78 Sec. 31 Twp. 19 R. 25WWell No. 1 GantzChalmette Oil

Company

FIRST REPORT

Contractor

SE NE NW

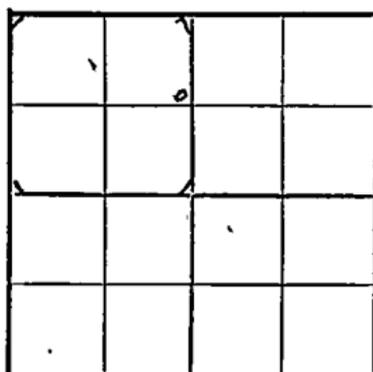SECTION PLAT990 Ft. from N. Line Ft. from S. Line330 Ft. from E. Line Ft. from W. LineNess CountyLocation XRig up Drilling and Remarks: **RECORD**Cased in., ft.Sand Gas Oil Total Depth **PRODUCTION**1st 24 hrs. Nat. 1st 24 hrs. after shot Gas Cu. Ft.Dry Hole Abandoned

Date

SEP 5 1945 19S. J. LEWIS

Scout

Kansas Pool Name Manteno

~~KANSAS~~

Map No. 78 Sec. 31 Twp. 19 R. 25W

Well No. 1 Gantz

Chalmette Oil Company

COMPLETED Contractor

SE NE NW

E/2570
SECTION PLAT

990 Ft. from N. Line

_____ Ft. from S. Line

330 Ft. from E. Line

_____ Ft. from W. Line

Ness County

Location _____

Rig up _____

Drilling and Remarks:

Mis 4558
5" @ 4560
1500 acid
Prod 54 oil +
30% Water Prod
36° 42

RECORD

Cased _____ in., _____ ft.

Sand _____

Gas _____

Oil _____

Total Depth 4585

PRODUCTION

1st 24 hrs. Nat. _____

1st 24 hrs. after shot _____

Gas _____ Cu. Ft.

Dry Hole _____

Abandoned _____

Date

FEB 6 1946 19

S. J. LEWIS

1946

2/6 Miss. 4558
5" @ 4560
1500 acid.
TD 4585'
Pump 84 oil plus 30% wtr. Pot.
Grav. 36.0

COMPLETED