


Section 32 Township 19 Range 11 W

Well No. # 1 Knop

Company Hilton Drlg.

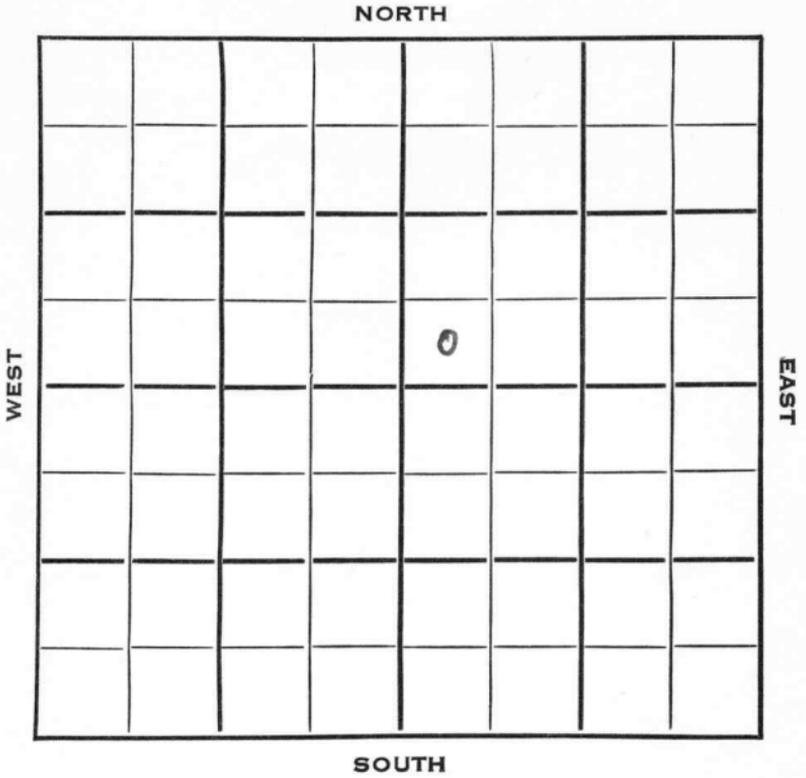



Sec. 32 Twp. 19 R. 11W

Well No. #1 Knop Farm

Hilton Drlg. Company

Buick Drlg. Contractor

N. Ellinwood Pool


Ft. from N. Line

330 Ft. from S. Line

Ft. from E. Line

330 Ft. from W. Line

SW SW NE

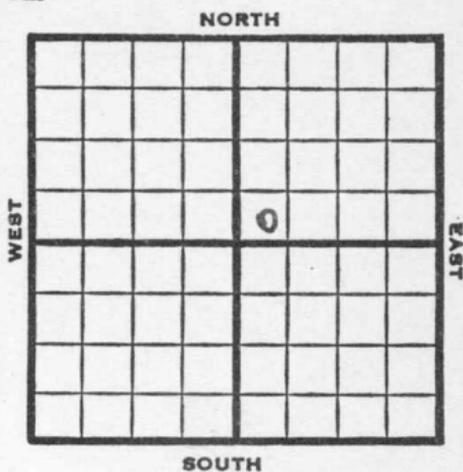

1953

Elev. 1786'

REPORT

7/1 Spud 6-24-53
8" @ 200
Drlg. 1755'

7/8 Top 2676, Heeb 2941, Br Li 3061, KC 3079,
DST 3244-54, 1/2 hrs., 30' M
840#
Drlg. 3314

8/5 Spud 6-24-53
Oil Well
TD 3348'
8" @ 200'
Top. 2676, Heeb 2941, Br. Lime 3061, KC 3079
DST 3244-54 opn 1/2 hr, rec 30' mud,
840# Arb 3340
TD 3348'
5" @ 3342'
DD 3345 1 goph 500 A CO to 3348
500 A 1 1/2 boph 1/4 bwph st-frac 2 1/2
boph 50% wtr.
Comp. 31 bopd 26 bw.

COMPLETED

County Barton State Kansas

Sec. 32 (Blk. Twp.) 19 (Sur. Rge.) 11W Map No.

Operator Hilton Drlg.

Well No. 1 Farm Knop

Elev. 1786 Location SW SW NE

			0		

330 Ft. From S Line NE

330 Ft. From W Line Quarter

1st. Report

Completion 406 5 1953

Remarks N. Ellinwood Pool
Buick Drlg. - Contr.

Spudding Date 6-24-53

Drlg. Data Oil well TD 3348

8" @ 200 Top. 2676 Heeb. 2941

Br. lime 3061 KC 3079 DST 3244-54

open 1/2 hr. Rec. 30' mud 840#

Arb. 3340 TD 3348 5" @ 3342 DD 3345

1 goph 500 A CO to 3348 500 A

1 1/2 boph 1/4 bwph st-frac 2 1/2 boph

50% wtr. Comp. 31 bopd 26 bw