


Section 32 Township 19 Range 11W

Well No. #1 Prather

Company Flourney & Hastin

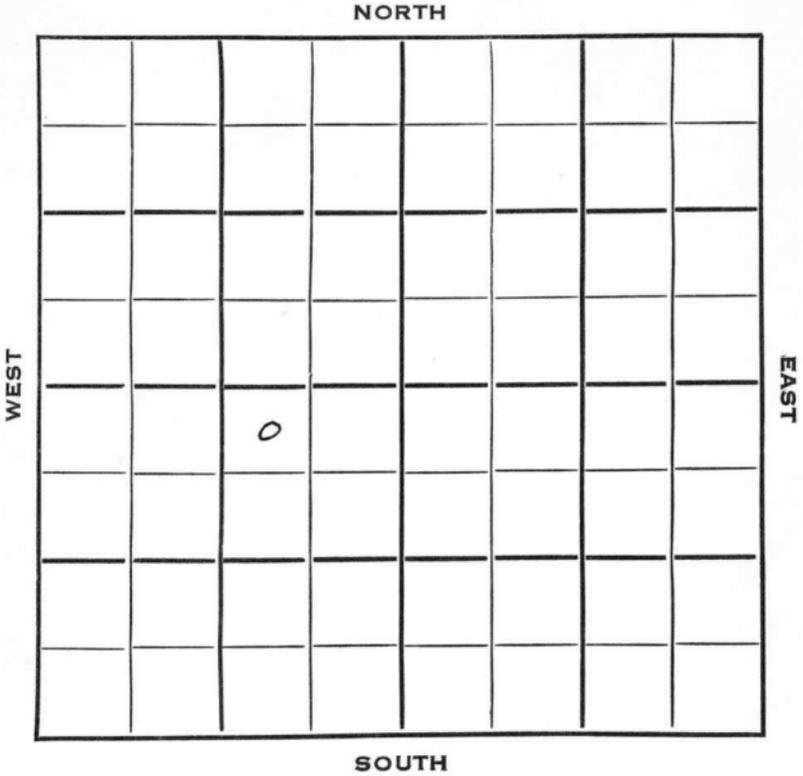

Sec. 32 Twp. 19 R. 11 W

Well No. # 1 Prather Farm

Flourney & Hastin Company

Flourney-Hastin Contractor


180 Ft. from N. Line

_____ Ft. from S. Line

990 Ft. from E. Line

_____ Ft. from W. Line

NW NE SW

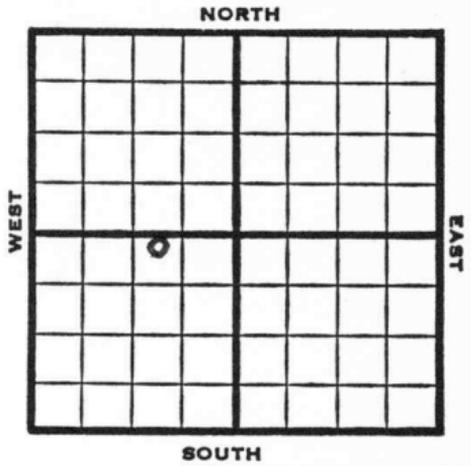

1953 Elev. 1784' REPORT

2/11 Spud 2-4-53
8" @ 197 Anhy 570
Drlg. 2855'

2/19 Heeb 2947, Br Li 3067, Lans
3083, Arb 3352
RTD 3369
5" @ 3355

2/26 CO 3369
PB 3364, 500A

3/12 D & A

3/19 "

3/25 Spud 2-4-53
D&A
TD 3369
8" @ 197
Anhy 570, Heeb 2947, Br lime
3067, Lans 3083, Arb. 3352
TD 3369
5" @ 3355
CO to 3 369
PB 3354 500A 1500A
Pipe Parted
D&A

ABANDONED

County Barton State Kansas

Sec. 32 (Blk. 19) (Sur. 11W) (Twp.) (Rge.) Map No.

Operator Flourney & Hastin

Well No. 1 Farm Prather

Elev. 1784 Location NW NE SW

ABANDONED					

180 Ft. From N Line SW

990 Ft. From E Line Quarter

1st. Report

Completion MAR 25 1953

Remarks

Flourney & Hastin - Contr.

Spudding Date 2-4-53

Drig. Data D & A TD 3369

8" @ 197 Anhy 570 Heeb. 2947

Br. lime 3067 Lans. 3083 Arb. 3352

TD 3369 5" @ 3355 CO to 3369

PB 3354 500 A 1500 A pipe parted

D & A