


Barton

Section 32 Township 19 Range 11W

Well No. #1 Thompson

Company Trans-Era

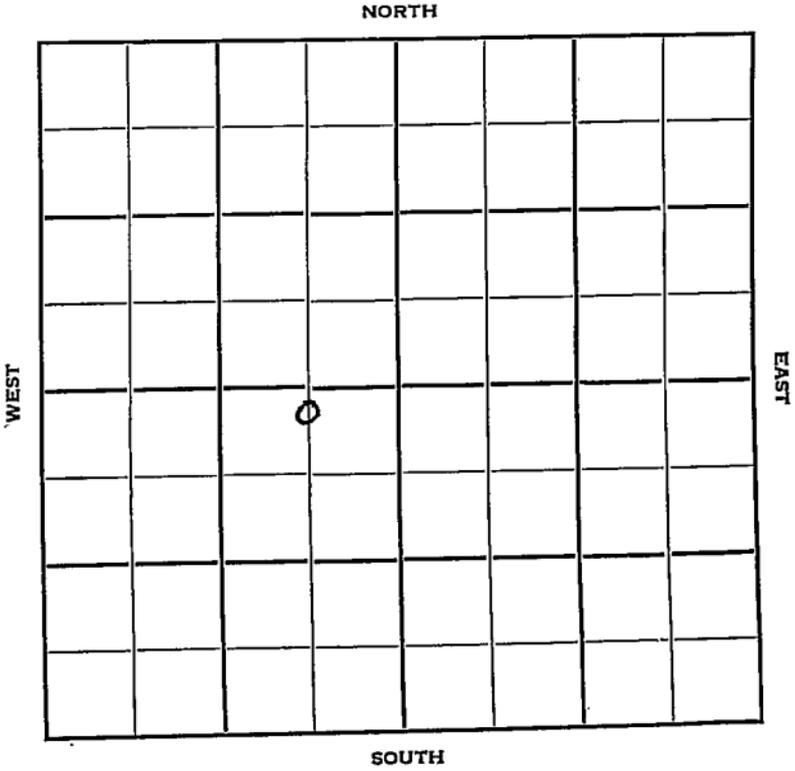

Sec. 32 Twp. 19 R. 11W

Well No. #1 Thompson Farm

Trans-Era Company


Trans-Era Contractor

330 Ft. from N. Line

..... Ft. from S. Line

660 Ft. from E. Line

..... Ft. from W. Line

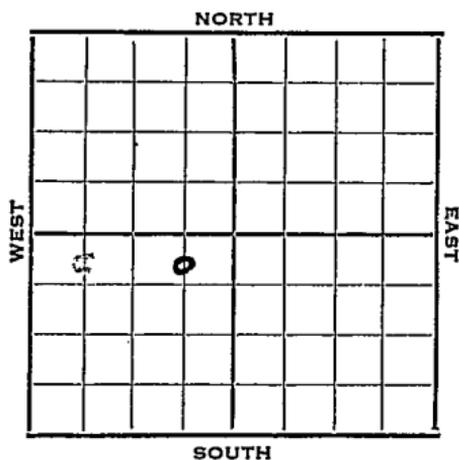

C N L NE SW

1953 Elev. 1784' REPORT

3/18 Spud 3-10-53
8" @ 192
Drlg. 2052'

3/26 Anhy 560, Top 2680, Heeb 2941,
Lans 3080,
DST 3161-66, 1/2 hrs., 130'
GCM
DST 3251-64, 1 hr., 55' SW&M
950#

4/1 Arb. 3352
Spud 3-10-53
D & A
TD 3366
8" @ 192'
Anhy 560, Top. 2680, Heeb 2941, Lans
3080
DST 3161-66 open 1/2 hr. Rec 130' gcm
DST 3251-64 open 1 hr. Rec 55' sw & mud
950# Arb 3352
TD 3366
D & A

ABANDONED

County Barton State Kansas

Sec. 32 (Blk. Twp.) 19 (Sur. Rge.) 11W Map No.

Operator Trans-Era

Well No. 1 Farm Thompson

Elev. _____ Location C N L NE SW

FIRST REPORT	
o	

330 Ft. From N Line SW

660 Ft. From E Line Quarter

1st. Report MAR 18 1953

Completion _____

Remarks _____

Trans-Era - Contr.

Spudding Date 3-10-53

Drlg. Data _____

8" @ 192 drlg. 2052

