


Rice

KANSAS

Section 32 Township 19 Range 10-W

Well Number 8 a. J. Stolz

Company Gulf

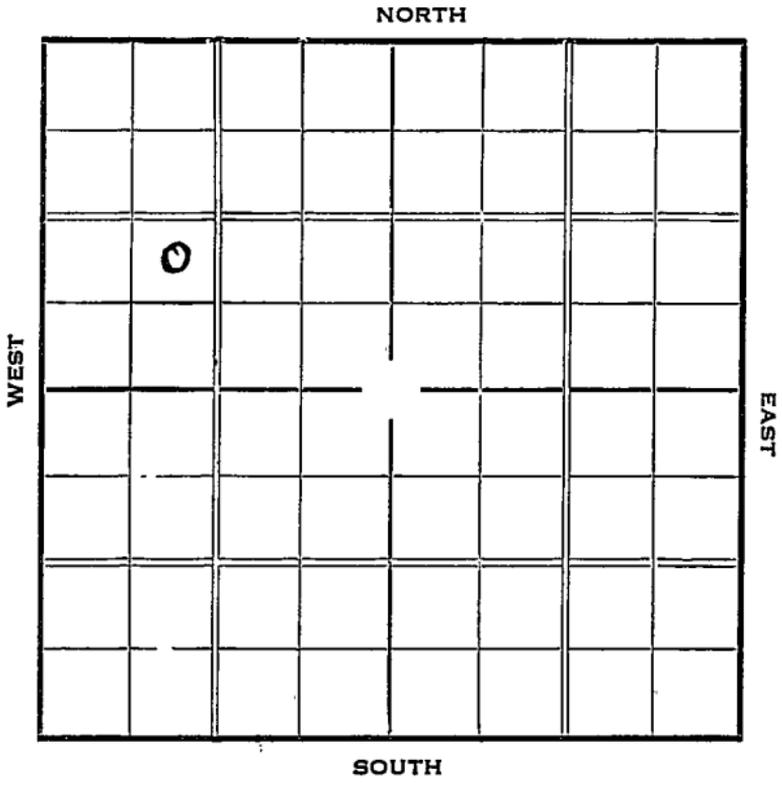

Rice

Form 252-A—5M—7-36—Palace

KANSAS

Sec. 32 Twp. 19 R. 10-W

Well No. 8 A.J. Stoltz Farm

Gulf Company


Ft. from N. Line

990 Ft. from S. Line

Ft. from E. Line

990 Ft. from W. Line

Elev. 1785

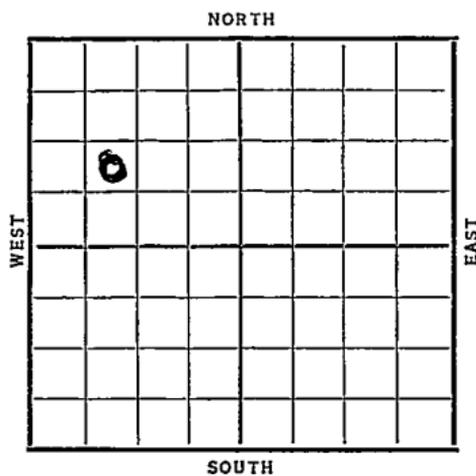

Date	REPORT
1937	
1/6	Rigging up
1/14	10" @ 175'. Drlg. 1110'.
1/21	Drlg. 2850'.
1/28	Sil. 3283'. 7" @ 3288'.
	T. D. 3291'. RUST.
2/4	T.D. 3298, 100 acid
	Pump 878 bbls 14 hrs.
2/10	Sil. 3283'.
	T. D. 3298'.
	1000 acid.
	Potential 1470.
	COMPLETED

KANSAS

Map No. 46 Sec. 32 Twp. 19 R. 10W

Well No. S. A. J. Stoltz

Gulf. Company

Contractor

SECTION PLAT

o			

_____ Ft. from N. Line

990 Ft. from S. Line

_____ Ft. from E. Line

990 Ft. from W. Line

FIRST REPORT

Location _____

Rig up _____

Drilling and Remarks:

Rigging up

RECORD

Cased _____ in., _____ ft.

Sand _____

Gas _____

Oil _____

Total Depth _____

PRODUCTION

1st 24 hrs. Nat. _____

1st 24 hrs. after shot _____

Gas _____ Cu. Ft.

Dry Hole _____

Abandoned _____

Date

JAN 6 1937₁₉

S. J. LEWIS Scout

Map No. _____ Sec. 32 Twp. 19 R. 10W



Contractor _____

SECTION PLAT

_____ Ft. from N. Line

990 Ft. from S. Line

_____ Ft. from E. Line

990 Ft. from W. Line

0			

COMPLETED

Location _____

Rig up _____

Drilling and Remarks:

Sil 3283
1000 acid
Potential
1470

RECORD

Cased _____ in., _____ ft.

Sand _____

Gas _____

Oil _____

Total Depth 3295

PRODUCTION

1st 24 hrs. Nat. _____

1st 24 hrs. after shot _____

Gas _____ Cu. Ft.

Dry Hole _____

Abandoned _____

Date

FEB 10 1937 ₁₉

S. J. LEWIS Scout