


Section..... 32 Township..... 19 Range 10W

Well Number..... 9 A. J. Stoltz

Company..... Gulf

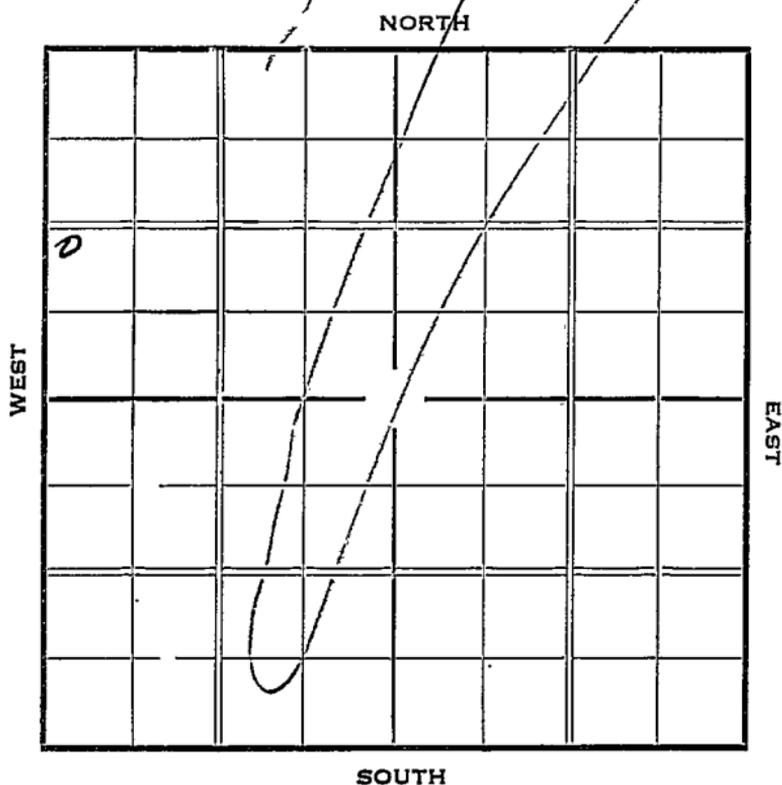

KANSAS

Map No. 46 Sec. 32 Twp. 19 R. 10W

Well No. 9 G. J. Stultz

G. J. Stultz Company

Contractor

SECTION PLAT

0			

_____ Ft. from N. Line

990 Ft. from S. Line

_____ Ft. from E. Line

330 Ft. from W. Line

FIRST REPORT

Location _____

Rig up _____

Drilling and Remarks:

Rig

RECORD

Cased _____ in., _____ ft.

Sand _____

Gas _____

Oil _____

Total Depth _____

PRODUCTION

1st 24 hrs. Nat. _____

1st 24 hrs. after shot _____

Gas _____ Cu. Ft.

Dry Hole _____

Abandoned _____

Date _____

JAN 13 1937

S. J. LEWIS Scout

Map No. _____ Sec. 32 Twp. 19 R. 10W

Well No. 9 A. J. Stoltz

Gulf Company

Contractor

SECTION PLAT

6			

_____ Ft. from N. Line

990 Ft. from S. Line

_____ Ft. from E. Line

330 Ft. from W. Line

COMPLETED

Location _____

Rig up _____

Drilling and Remarks:

Sil 3273
1000 acid
Potential
997

RECORD

Cased _____ in., _____ ft.

Sand _____

Gas _____

Oil _____

Total Depth 3286

PRODUCTION

1st 24 hrs. Nat. _____

1st 24 hrs. after shot _____

Gas _____ Cu. Ft.

Dry Hole _____

Abandoned _____

Date _____

FEB 24 1937

S. J. LEWIS Scout